

KANSAS


Form 51—5M—7-39—Palace

McPherson

Section 31 Township 20 Range 5-W

Well No. #4 Johnson

Company Sunray

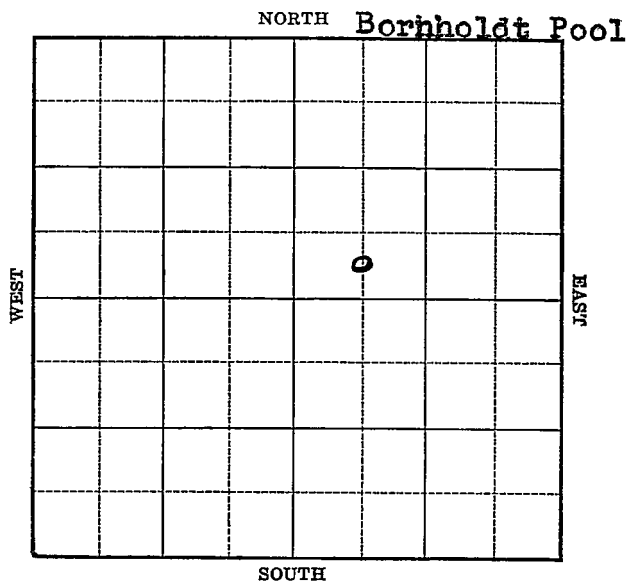

KANSAS

McPherson


Sec. 31 Twp. 20 R. 5 -WWell No. #4 Johnson FarmSunray

Company

(Bornholdt)

 Ft. from N. Line330 Ft. from S. Line Ft. from E. Line660 Ft. from W. Line

Elev. 1516

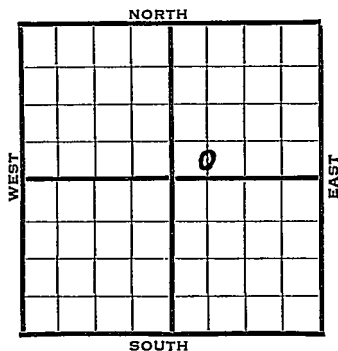

1940	REPORT
6/12	Cellar.
6/20	Derrick.
6/27	"
7/3	"
7/11	"
7/18	Drlg. 2819'
7/25	Chat. 3304' 7" - 3307'
	T.D. 3337' 1000' oil 1 hour.
	Shut down.
8/2	T.D. 3357' 800' fluid. P.B.
8/8	T.D. 3358' P.B. to 3354'
	Shot 20 qts. 3324-34' C.O.
8/14	" " " " "
8/21	Chat. 3304'
	7" - 3307'
	T.D. 3358'
	P.B. to 3344'
	Shot 20 qts. 3334-44'
	15 bbls.
	COMPLETED

Map No. 48 Sec. 31 Twp. 20 R. 5WWell No. 4 JohnsonSunray

Company

Contractor

FIRST REPORT

SECTION PLAT

C S L SW NE

 Ft. from N. Line330 Ft. from S. Line Ft. from E. Line660 Ft. from W. Line

BORNHOLDT POOL

Location Rig up

Drilling and Remarks:

Cellar

RECORD

Cased in., ft.Sand Gas Oil Total Depth

PRODUCTION

1st 24 hrs. Nat. 1st 24 hrs. after shot Gas Cu. Ft.Dry Hole Abandoned

Date

JUN 12 1940

19

S. J. LEWIS Scout

Map No. _____ Sec. 31 Twp. 20 R. 5WWell No. 4 JohnsonSunray

Company _____

Contractor _____

COMPLETED**C S L SW NE**

_____ Ft. from N. Line

330 Ft. from S. Line

_____ Ft. from E. Line

660 Ft. from W. Line**BORNHOLDT POOL****SECTION PLAT**

Location _____

Rig up _____

Drilling and Remarks:

*Cha 83304**7" @ 3307**PB 3344**20 gts 3334-44**15 gts***RECORD**

Cased _____ in., _____ ft.

Sand _____

Gas _____

Oil _____

Total Depth *7173058***PRODUCTION**

1st 24 hrs. Nat. _____

1st 24 hrs. after shot _____

Gas _____ Cu. Ft.

Dry Hole _____

Abandoned _____

Date

AUG 21 1940 19 _____ S. J. LEWIS Scout