

KANSAS

Form 51-5M-7-39-Palace


McPherson

Section 31 Township 20 Range 5-W

Well No. #2 Johnson Est.

Company Sunray & Fain Drlg.

NORTH Bornholdt Pool

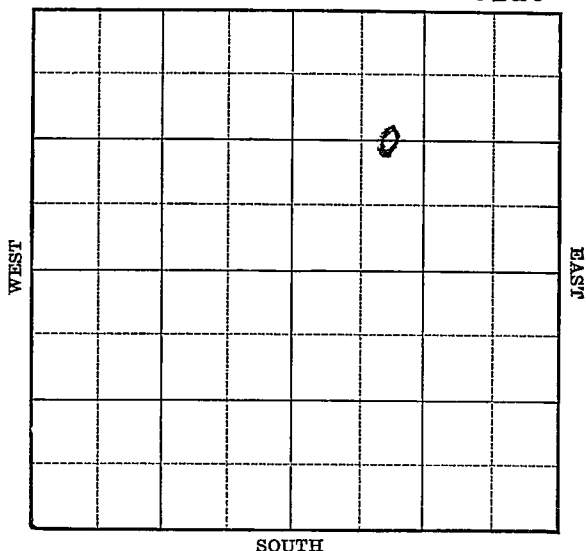

KANSAS


McPherson

Sec. 31 Twp. 20 R. 5-WWell No. #2 Johnson Est. FarmSunray & Fain Drlg. Company

(Bornholdt)

1320 Ft. from N. Line Ft. from S. Line Ft. from E. Line990 Ft. from W. Line

Elev. 1533

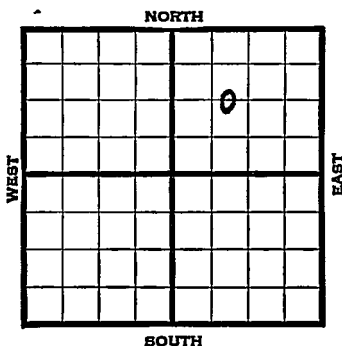

1939	REPORT
11/22	Building derrick.
11/29	Derrick.
12/7	10" - 162' WOC.
12/12	TD 2785 Lost circulation (Tel)
12/14	Drlg. 2785'
12/15	Dlg. 3250 (Tel)
12/19	Top Chat 3329½ 7" 3330 TD 3333
	show oil Rust (Tel)
12/28	" " "
1940	
1/2	1st oil 3363-64' 100' oil in hole.
	Dlg. 3364' (Tel)
1/4	Shot 30 qts. 3350-56'
	Shot 40 qts. 3325-38'
	2950' oil. C.O.
1/11	T.D. 3426' Base Chat 3415'
	Swab 10 water 25 oil. Swab down
	May shoot.
1/18	" "
1/23	TD 3426 PB 3380 Shot 60 qts 3360-80
	CO (Tel)
	OVER

1940

2/1 TD 3426' P.B. 3380'
Shot 60 qts. 3360-80' C.O.

2/8 Shot 100 qts. 3358-80' C.O.

2/15 " " " " " "

2/23 1500' oil 2 days. C.O.

2/29 " " " "

3/8 " " " "

3/14 " " " "

3/21 " " " "

3/28 " " " "

4/3 Chat. 3329 $\frac{1}{2}$ '
7" - 3330'
T.D. 3426'
Shot 160 qts.
P.B. 3380'
15 bbls. oil.

COMPLETED

Map No. 48 Sec. 31 Twp. 20 R. 5WWell No. 2 Johnson Est.Sunray & Fain Drig. Company


Contractor

FIRST REPORT

C E L W $\frac{1}{2}$ NE1320 Ft. from N. Line Ft. from S. Line Ft. from E. Line990 Ft. from W. Line

BORNHOLDT POOL

SECTION PLAT

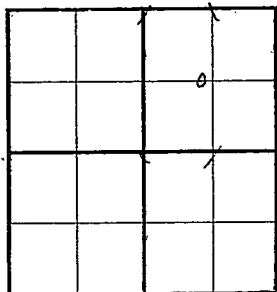Location Rig up

Drilling and Remarks:

Building Derrick

RECORD

Cased in., ft.Sand Gas Oil Total Depth

• PRODUCTION

1st 24 hrs. Nat. 1st 24 hrs. after shot Gas Cu. Ft.Dry Hole Abandoned

Date

NOV 22 1939S. J. LEWIS Scout

Map No. ~~48~~ Sec. **31** Twp. **20** R. **5W**Well No. **2 Johnson Est.****Sunray & Fain Drilling** Company

Contractor

COMPLETED
C E L W¹/₂ NE**1320** Ft. from N. Line

_____ Ft. from S. Line

_____ Ft. from E. Line

990 Ft. from W. Line**BORNHOLDT POOL****SECTION PLAT**

		e	

Location _____

Rig up _____

Drilling and Remarks:

*Ok at 3329 1/2**7" @ 3330**Shut 1609 to.**1588 1/2**P.B. 3350***RECORD**

Cased _____ in., _____ ft.

Sand _____

Gas _____

Oil _____

Total Depth **3426****PRODUCTION**

1st 24 hrs. Nat. _____

1st 24 hrs. after shot _____

Gas _____ Cu. Ft.

Dry Hole _____

Abandoned _____

Date

APR 3 1940 19 **S. J. LEWIS** Scout