

KANSAS

McPherson


Form 51—5M—7-39—Palace

Section 31 Township 20 Range 5-W

Well No. #2 Johnson

Company Continental

NORTH **Bornholdt Pool**

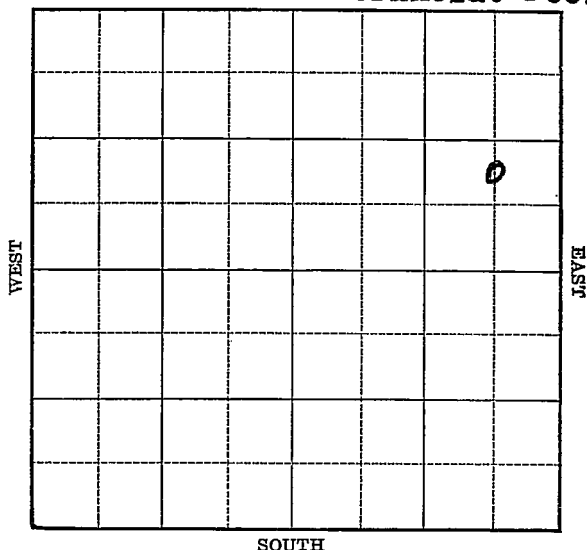


Sec. 31 Twp. 20 R. 5-WWell No. #2 Johnson Farm- Continental Company

(Bornholdt)

 Ft. from N. Line990 Ft. from S. Line660 Ft. from E. Line Ft. from W. Line

Elev. 1547

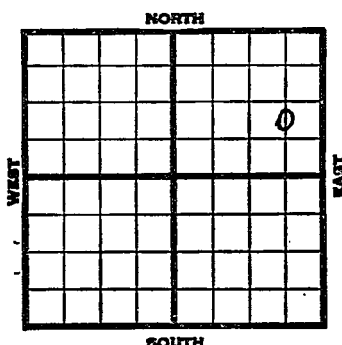

	REPORT
1940	
1/10	Rotary.
1/12	Moving in rotary (Tel)
1/18	10" - 143'
	Drlg. 677'
1/23	Dlg. 2840 (Tel)
1/31	Top Chat 3331 6" 3341 T.D. 3347
	Some saturation Rust (Tel)
	Running 25' higher on Chat than Cont. #1
	Johnson north offset which flowed 1011 bbls.
	in 8 hrs.
2/8	Dlg. 3373 in Chat 500' fluid in hole
	Mostly oil (Tel)
2/13	2800' OIH at 3385 T.D. 3395
	2 bailers water per hour Cemented
	back WOC (Tel)
2/23	P.B. to 3382' Swab 3 bbls. per
	hour. Shut down.
2/29	Shot 25 qts. 3365-75'
	3250' oil. No time given.
3/8	" " " " "
	OVER

1940

3/14 Shot 30 qts. 3365-75'
1600' oil 16 hours. C. O.

3/21 " " " " "

3/27 Chat 3331'

6" - 3341'

T.D. 3395'

P.B. to 3382'

Shot 25 qts. 3365-75'

Shot 30 qts. 3365-75'

Potential 260 bbls., pump.

COMPLETED

Map No. 48 Sec. 31 Twp. 20 R. 5WWell No. 2 JohnsonContinental

Company

Contractor

FIRST REPORT

C N L SE NE

_____ Ft. from N. Line

990 Ft. from S. Line660 Ft. from E. Line

_____ Ft. from W. Line

SECTION PLAT

			o

BORNHOLDT POOL

Location _____

Rig up _____

Drilling and Remarks:

Rotary

RECORD

Cased _____ in., _____ ft.

Sand _____

Gas _____

Oil _____

Total Depth _____

PRODUCTION

1st 24 hrs. Nat. _____

1st 24 hrs. after shot _____

Gas _____ Cu. Ft.

Dry Hole _____

Abandoned _____

Date

JAN 10 1940 19

S. J. LEWIS

Scout

Map No. 48 Sec. 31 Twp. 20 R. 5WWell No. 2 JohnsonContinental Company

Contractor

COMPLETED

C N L SE NE

 Ft. from N. Line990 Ft. from S. Line660 Ft. from E. Line Ft. from W. Line**SECTION PLAT**

			o

BORNHOLDT POOLLocation Rig up

Drilling and Remarks:

*Oka 3331.**6" C 3341.**P.B. 3382.**209 to 3365-75**309 to 3365-75**Pump 260 P.S.***RECORD**Cased in., ft.Sand Gas Oil Total Depth 3395**PRODUCTION**1st 24 hrs. Nat. 1st 24 hrs. after shot Gas Cu. Ft.Dry Hole Abandoned

Date

MAR 27 1940 19

S. J. LEWIS

Scout