

Form 51-5M-7-39-Palace


McPherson

Section 31 Township 20 Range 5-W

Well No. #3 Johnson

Company Sunray

NORTH Bornholdt Pool

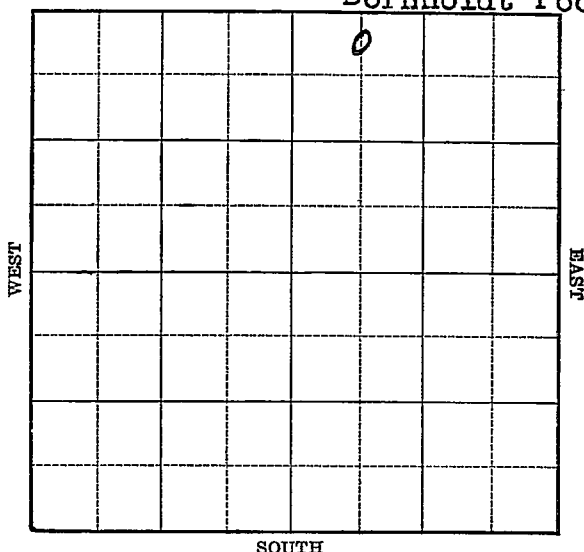

KANSAS

McPherson

Sec. 31 Twp. 20 R. 5-WWell No. #3 Johnson FarmSunray

Company

(Bornholdt)


330 Ft. from N. Line

Ft. from S. Line

Ft. from E. Line

660 Ft. from W. Line

Elev. 1534

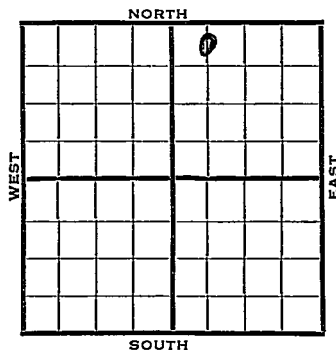

	REPORT
1940	
4/10	Move in Mat'l.
4/18	10" - 160' WOC.
4/25	Drlg. 2428'
5/2	Miss. 3314-18' T.D. 7" - 3316' WOC.
5/9	Drlg. 3370' 2000' oil.
5/16	T.D. 3381' H.F.O. 35 qts. 3346-81' C.O.
5/23	" " " "
5/29	Swab 14 bbls. per hour for 4 hours.
6/5	Chat. 3314' 7" - 3316' T.D. 3381' Shot 35 qts. 3346-81' Potential 340 bbls., pump.

COMPLETED

Map No. 48 Sec. 31 Twp. 30 R. 5WWell No. 3 JohnsonSunray

Company

Contractor

FIRST REPORT

C N L NW NE

330 Ft. from N. Line Ft. from S. Line Ft. from E. Line660 Ft. from W. Line

BORNHOLDT POOL

SECTION PLAT

		<u>0</u>	

Location Rig up

Drilling and Remarks:

Move in Matl.

RECORD

Cased in., ft.Sand Gas Oil Total Depth

PRODUCTION

1st 24 hrs. Nat. 1st 24 hrs. after shot Gas Cu. Ft.Dry Hole Abandoned

Date

APR 10 1940S. J. LEWISScout

Map No. 48 Sec. 31 Twp. 20 R. 5WWell No. 3 JohnsonSunray Company

Contractor

COMPLETED

C N L NW NE

330 Ft. from N. Line

_____ Ft. from S. Line

_____ Ft. from E. Line

660 Ft. from W. Line

SECTION PLAT

		0	

BORNHOLDT POOL

Location _____

Rig up _____

Drilling and Remarks:

*Ok 73314**7" 33316**359 to 3346 81**Pump 340 RY*

RECORD

Cased _____ in., _____ ft.

Sand _____

Gas _____

Oil _____

Total Depth 3381

PRODUCTION

1st 24 hrs. Nat. _____

1st 24 hrs. after shot _____

Gas _____ Cu. Ft.

Dry Hole _____

Abandoned _____

Date

JUN 5 1940 19S. J. LEWIS Scout