

KANSAS


Rice

Form 51—5M—11-38—Palace

Section 31 Township 20 Range 7-W

Well No. #1 Johnson Est.

Company C. L. Carlock et al

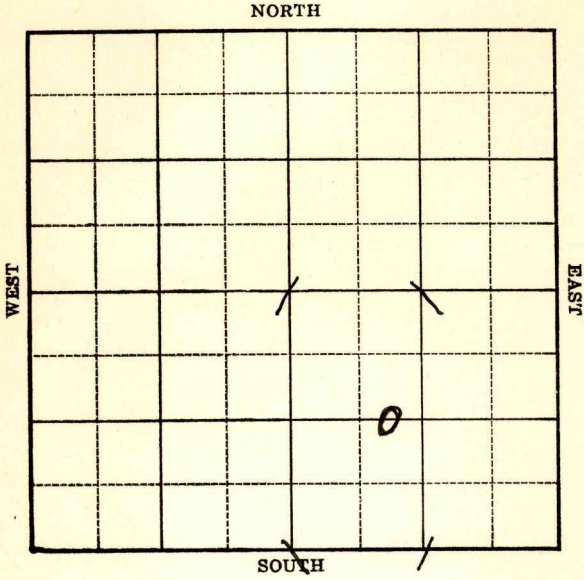


KANSAS

Rice

Sec. 31 Twp. 20 R. 7-WWell No. #1 Johnson Est. FarmC. L. Carlock et al Company Ft. from N. Line1320 Ft. from S. Line Ft. from E. Line990 Ft. from W. Line

Elev. 1630

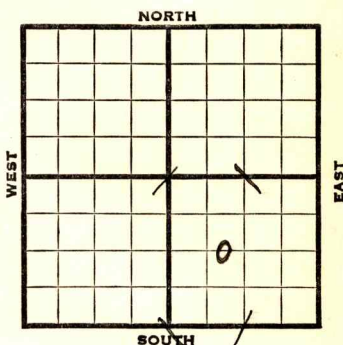

1938	REPORT
12/7	Location
12/15	"
12/23	R. R.
12/30	"
1939	
1/6	"
1/13	"
1/20	"
1/27	"
2/3	10" - 145'. WOC.
2/10	Drlg. 2075'.
2/17	Topeka 2420' Lans. 2890'
	Cong. 3325 ³³¹⁷ T.D. 3325 ³³¹⁹
	5" - 3320 RUST.
2/23	$\frac{3}{4}$ Correction: 3325 equals 3319'
	Cong. 3317' 5" - 3318'
	Pay 3320-25' T.D.
	Est. 10 M gas & 100 bbls. oil.
3/3	Flow 103 oil in 1 hours.
	Shut in.
	OVER

1939

3/10

T.D. 3321' (Corrected)

Flowed 61 oil in 1 hour.

Temporary Potential 208 bbls.

3/15

5" - 3318'

Cong. 3317'

T. D. 3321' (Corrected)

Flow 566 bbls. 8 hours.

Potential 1698 bbls.

COMPLETED

Rice

KANSAS


Map No. 49 Sec. 31 Twp. 20 R. 7WWell No. 1 Johnson Est.C. L. Carlock et al Company

Contractor

Amerada Farm-out

FIRST REPORT

SECTION PLAT

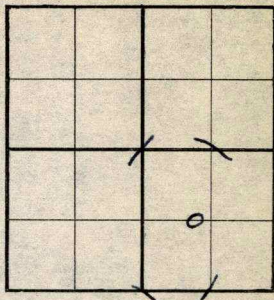C E L W $\frac{1}{2}$ SE Ft. from N. Line1320 Ft. from S. Line Ft. from E. Line990 Ft. from W. LineLocation XRig up Drilling and Remarks:

RECORD

Cased in., ft.Sand Gas Oil Total Depth

PRODUCTION

1st 24 hrs. Nat. 1st 24 hrs. after shot Gas Cu. Ft.Dry Hole Abandoned

Date

DEC 7 - 1938 19H. D. Hatfield Scout

Map No. 49 Sec. 31 Twp. 20 R. 7WWell No. 1 Johnson Est.C. L. Carlock etal Company

Contractor

COMPLETED

C E L W $\frac{1}{2}$ SE

Ft. from N. Line

1320 Ft. from S. Line

Ft. from E. Line

990 Ft. from W. Line

SECTION PLAT

WHERRY POOL

Location _____

Rig up _____

Drilling and Remarks:

Flow 56 6/8

Pot 1698

RECORD

Cased 5 in., 3318 ft.Sand cong 3317

Gas _____

Oil _____

Total Depth 3321

PRODUCTION

1st 24 hrs. Nat. _____

1st 24 hrs. after shot _____

Gas _____ Cu. Ft.

Dry Hole _____

Abandoned _____

Date

MAR 15 1939 19

H. D. Hatfield Scout