

KANSAS


Rice

Form 51—5M—7-39—Palace

Section 31 Township 20 Range 7-W

Well No. #2 Brothers "A"

Company Shell

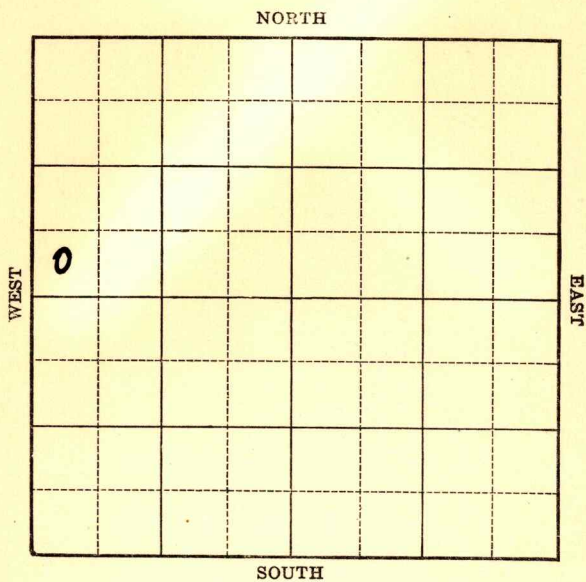

Rice

KANSAS

Map No. 49 Sec. 31 Twp. 20 R. 7 WWell No. 2 Brothers "A"

Shell

Company

Contractor

SW NW

SECTION PLAT

 Ft. from N. Line330 Ft. from S. Line Ft. from E. Line330 Ft. from W. Line

WHERRY POOL

Location Rig up

Drilling and Remarks:

Pits

RECORD

Cased in., ft.Sand Gas Oil Total Depth

PRODUCTION

1st 24 hrs. Nat. 1st 24 hrs. after shot Gas Cu. Ft.Dry Hole Abandoned

Date

JAN 24 1940

19

S. J. LEWIS

Scout

Rice

KANSAS

Map No. 49 Sec. 31 Twp. 20 R. 7WWell No. 2 Brothers "A"

Shell

Company

Contractor

COMPLETED

SW NW

SECTION PLAT

0			

Ft. from N. Line

330 Ft. from S. Line

Ft. from E. Line

330 Ft. from W. Line

WHERRY POOL

Location

RECORD

Cased _____ in., _____ ft.

Sand _____

Gas _____

Oil _____

Total Depth 3325

Rig up

Drilling and Remarks:

Core 33154" @ 3315Pump 141 & 1/2

PRODUCTION

1st 24 hrs. Nat. _____

1st 24 hrs. after shot _____

Gas _____ Cu. Ft.

Dry Hole _____

Abandoned _____

Date

MAR 20 1940

19

S. J. LEWIS

Scout