Rice


Form 51-5M 5-37 Petrol

KANSAS

Section 32 Township 20 Range 7-W

Well No. 1 Lantz

Company Shell

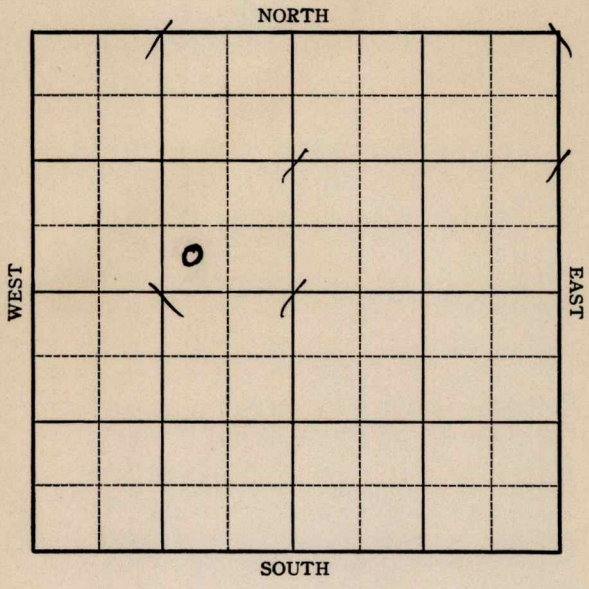


Form 252-A—5M—9-37 KANSAS Rice

Sec. 32 Twp. 20 R. 7-W

Well No. #1 Lantz Farm

Shell Company

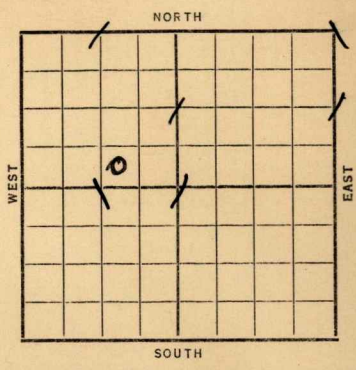

____ Ft. from N. Line

330 Ft. from S. Line

990 Ft. from E. Line

____ Ft. from W. Line

Elev. 1626

Date	REPORT
1937	
12/15	Location
12/24	R U R
12/31	15" @ 146'. Drlg. 2521'.
1938	
1/7	Cong. 3314'. T.D. 3333'.
	S.D.O. No shows.
1/14	Cored 3333-35'. Recovered 2'
	good saturation. 7" @ 3326'.
	RUST.
1/20	T.D. 3335' 2500' oil in 3
	days. Testing.
1/28	Chat 3344' T.D. 3347'
	2600' oil from Cong. Testing.
2/4	Shot 10 qts. 3342-32'
	Shot 20 qts 3346-32'
	Swb'g 5 bbls oil P.H.
2/11	T.D. 3350'. Swabbing 35 bbls.
	oil per day.
2/18	" " "
2/26	" " "

OVER

1938

3/4 TD 3350' SD.

3/9 7" @ 3326'.
Chat 3344'.
T.D. 3350'.
Pump 40 oil in 6 hrs.
15 bbls.
Minimum well.

COMPLETED

Form 26—1M Bks.—2-29 Rice KANSAS

Map No. 49 Sec. 32 Twp. 20 R. 7W

Well No. 1 Lantz

Shell Company

Contractor

FIRST REPORT

SW SE NW


Ft. from N. Line

330 Ft. from S. Line

990 Ft. from E. Line

Ft. from W. Line

SECTION PLAT

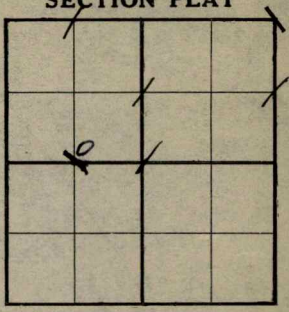

Location X

Rig up

Drilling and Remarks:

RECORD

Cased in., ft.

Sand

Gas

Oil

Total Depth

PRODUCTION

1st 24 hrs. Nat.

1st 24 hrs. after shot

Gas Cu. Ft.

Dry Hole

Abandoned

Date

DEC 15 1937 19

H. D. Hatfield Scout

Form 26—1M Bks.—2-29

Rice KANSAS

Map No. 49 Sec. 32 Twp. 20 R. 7W

Well No. #1- Lantz

Shell Company

Contractor

COMPLETED

SW SE NW


Ft. from N. Line

330 Ft. from S. Line

990 Ft. from E. Line

Ft. from W. Line

SECTION PLAT

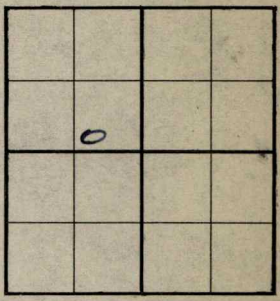

Location

Rig up

Drilling and Remarks:

Pump 40 oil in 6 hrs

15 bbls

minimum

well

RECORD

Cased 7 in., 3326 ft.

~~Sand~~ Chat 3344

Gas

Oil

Total Depth 3350

PRODUCTION

1st 24 hrs. Nat.

1st 24 hrs. after shot

Gas Cu. Ft.

Dry Hole

Abandoned

Date

MAR 9 - 1938 19

H. D. Hatfield Scout