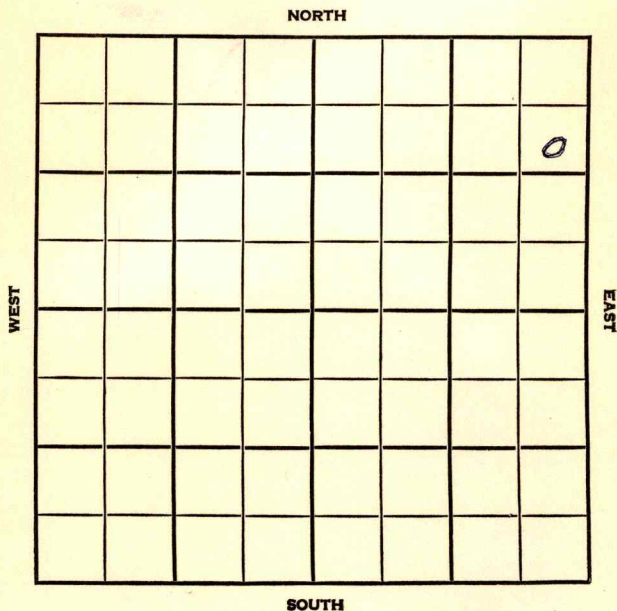


Section 32 Township 20 Range 7WWell No. #3 DavisCompany H.C. Bennett & ~~Gould~~

Co.

County Rice Elev. 1622
 Sec. 32 Twp. 20 Rgs. TW
 Company H.C. Bennett & Gould
 Farm Name Davis No. 3

TOPS	DEPTH	LOG	DATUM	Loc. in Sec.
Anh.				SE NE NE
TP.				
H.	2690			
Tr.	2709			
Dg.	2714			
BL.	2849			
L.	2873			
K.C.				Geol.
B.K.C.	3215			Contr.
Ce.				
C. 5614	3306			Bennett & Ro
M. 59 chert	3312			erts Tools
M.				Pool
K.				Wherry
Mz.				
Me.				
V.				
S.				
S.				
A.				
R.				
Pe.				
G.				
T.D.	3322			COMPLETE

56

No.

Sec.

T.

R.

Date Comm.

MIRT

JUL 31 '56

10-26-56 878

200/175

10 3230

NOV 7 '56

5 1/2 3319

NOV 13 '56

NOV 21 '56 NOV 28 '56

DEC 5 '56

MIRT

DEC 12 '56

DEC 19 '56

DEC 26 '56

CO 3322

S.D. for holiday

JAN 2 '57

DD @ 3332

JAN 9 '57

DD 3336

Frac

JAN 16 '57

POP

JAN 23 '57

JAN 30 '57

FEB 6 '57 FEB 13 '57

P & F/W 25 Bond

no/wt.

County Rice Elev. _____
 Sec. 32 Twp. 20 Rge. 7W
 Company Bennett & Gould
 Farm Name Davis No. 3

TOPS	DEPTH	LOG	DATUM	Loc. in Sec.
Anh.				SE NE NE
TP.				
H.				
Tr.				
Dg.				
Bl.				
L.				Geol. _____
K.C.				Contr. _____
B.K.C.				Bennett & Roberts Tools
Ce.				Pool
C.				Wherry
M.				
M.				
K.				
Mz.				
Me.				
V.				
S.				
S.				
A.				
R.				
Pe.				
G.				
T.D.				



Date Comm.

MIRT

8000 1.5.1000

G. R.