FORM 51 5M 2-38 TPCO.


Rice

KANSAS

Section 32 Township 20 Range 7-W

Well No. 2 Deweese

Company Republic Nat.

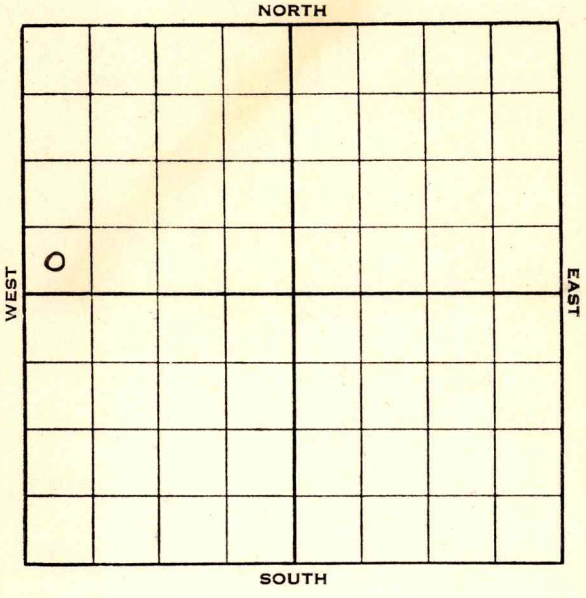


Form 252-A—5M—9-37 KANSAS Rice

Sec. 32 Twp. 20 R. 7-W

Well No. #2 Deweese Farm

Republic Nat. Company

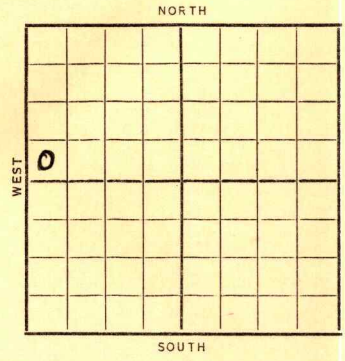

_____ Ft. from N. Line

330 Ft. from S. Line

_____ Ft. from E. Line

330 Ft. from W. Line

Elev. 1628

Date	REPORT
1938	
2/16	R U R
2/26	"
3/4	10" @ 112'. Drlg. 1585'.
3/11	Drlg. 3020'.
3/18	Cong. & 7" @ 3320'. T.D. 3320'.
	S.O. RUST.
3/25	T.D. 3350'. 300' fluid in 4 hrs.
	40% wtr.
4/1	T.D. 3350' C.O.
4/6	7" @ 3320'.
	Cong. 3320'.
	T.D. 3350'.
	Shot 10 qts.
	Potential 96 bbls.
	COMPLETED

Form 26—1M Bks.—2-29 Rice KANSAS

Map No. Sec. 32 Twp. 20 R. 7W

Well No. 2 Dewees

Republic Nat. Company

Contractor

FIRST REPORT

SW NW


Ft. from N. Line

330 Ft. from S. Line

Ft. from E. Line

330 Ft. from W. Line

SECTION PLAT

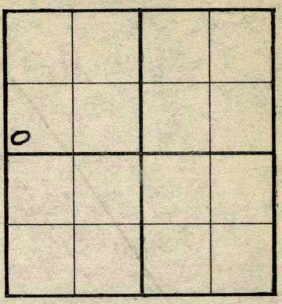

Location

Rig up

Drilling and Remarks:

RUR

RECORD

Cased in., ft.

Sand

Gas

Oil

Total Depth

PRODUCTION

1st 24 hrs. Nat.

1st 24 hrs. after shot

Gas Cu. Ft.

Dry Hole

Abandoned

Date

FEB 16 1938 19 H. D. Hatfield Scout

Form 26—1M Bks.—2-29

Rice KANSAS

Map No. 49 Sec. 32 Twp. 20 R. 7W

Well No. 2 Deweese

Republic Nat. Company

Contractor

COMPLETED

SW NW


Ft. from N. Line

330 Ft. from S. Line

Ft. from E. Line

330 Ft. from W. Line

SECTION PLAT

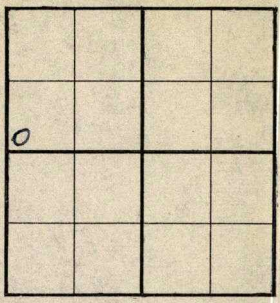

Location

Rig up

Drilling and Remarks:

shot 10 qts

Pot 96

RECORD

Cased 7 in., 3320 ft.

~~Sand~~ Cong 3320

Gas

Oil

Total Depth 3350

PRODUCTION

1st 24 hrs. Nat.

1st 24 hrs. after shot

Gas Cu. Ft.

Dry Hole

Abandoned

Date

APR 6 - 1938 19

H. D. Hatfield Scout