

Section 33 Township 20 Range 7W

Well No. 1 Colle

Company Paboo et al

Wherry Pool
NORTH

NORTH

WEST

EAST

SOUTH

KANSAS Rice



Sec. 33 Twp. 20 R. 7-W

Well No. #1 Colle Farm

Pabco etal.

Company

Wherry

990

Ft. from N. Line


Ft. from S. Line

330

Ft. from E. Line

Ft. from W. Line

SE NE SE

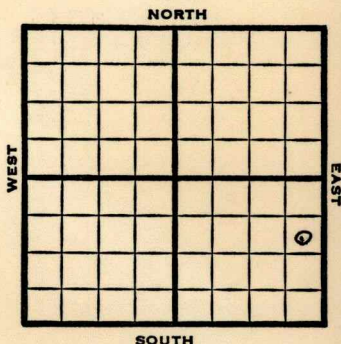

1948

Elev 1626'

REPORT

12/22

8"@ 110'

12/29

Conglomerate 3343-66 TD

Run 5"

1949

1/12

TD 3412'

Miss 3360'

Aband.

ABANDONED

Kansas

Wherry Pool

Map No. _____ Sec. 33 Twp. 20 R. 7WWell No. 1 CollePabco etal.

Company

FIRST REPORT

Contractor

SE NE SE

SECTION PLAT

990


Ft. from N. Line

Ft. from S. Line

330

Ft. from E. Line

Ft. from W. Line

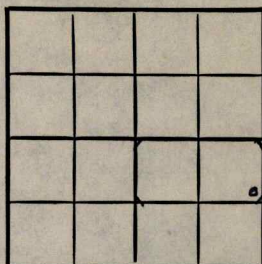

Rice County

RECORD

Location _____

Cased _____ in., _____ ft.

Rig up _____

Sand _____

Drilling and Remarks:

Gas _____

Oil _____

8" @ 110

Total Depth _____

PRODUCTION

1st 24 hrs. Nat. _____

1st 24 hrs. after shot _____

Gas _____ Cu. Ft.

Dry Hole _____

Abandoned _____

Date

DEC 22 1948

19

S. J. LEWIS

Scout

Map No. 49 Sec. 33 Twp. 20 R. ZW

Well No. 1 Colle

Pabco etal. Company

ABANDONED

Contractor

SE NE SE


E11626
SECTION PLAT

990 Ft. from N. Line

 Ft. from S. Line

330 Ft. from E. Line

 Ft. from W. Line

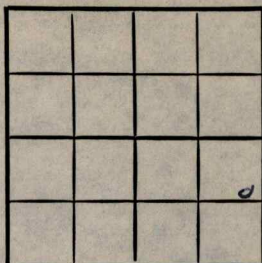

Rice County

RECORD

Location

Cased in., ft.

Rig up

Sand

Drilling and Remarks:

Gas

Miss 3360

Oil

Total Depth 3412

PRODUCTION

1st 24 hrs. Nat.

1st 24 hrs. after shot

Gas Cu. Ft.

Dry Hole

Abandoned

Date

JAN 12 1949 19

S. J. LEWIS Scout