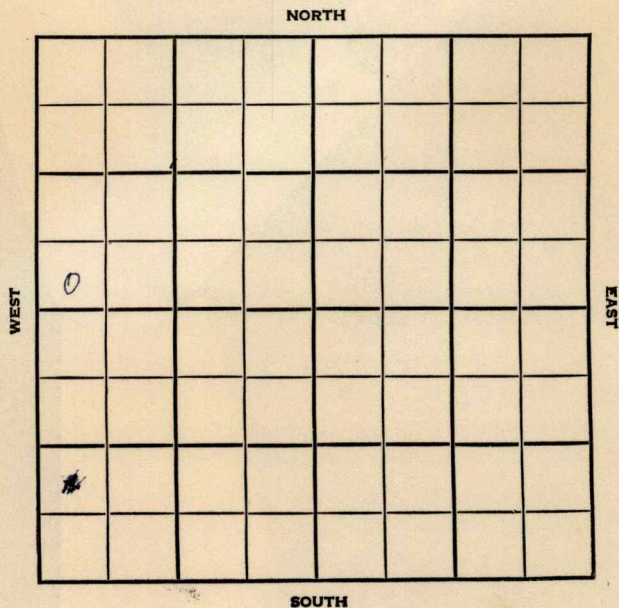


Section 33 Township 20 Range 7 WWell No. #1 ZwickCompany Francis Raymond

Rice

KANSAS

SEC.	TWP.	R.
33	20	7W

WELL NO.

#1 Zwick

FARM

COMPANY

Francis Raymond

CONTRACTOR

Salina

Wherry


Ft. from N. Line

Ft. from S. Line

Ft. from E. Line

Ft. from W. Line

SW SNNW

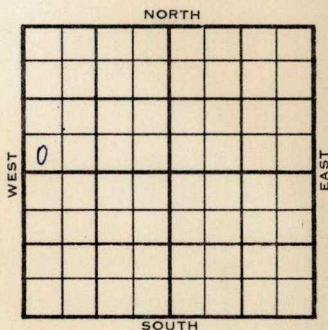

	ELEVATION	REPORT
1956	1622	
3-14	Comm. 3-10-56 8" @ 228/150 Drlg. 1525	
4-11	DST 3126-35 op 1 hr. rec. 50' socm, 20' mud,, 20' sw, 950/20" 5 $\frac{1}{2}$ " @ 3324/55 CO to 3328 DD 3342, Frac FU 2000' fluid S/ 10 bo, 10 bwph, 6 hrs., Comp. 25 bopd, 8 bw H. 2694 Dg. 2734 BL. 2854 L. 2879 C. Shly 3313 M. Cg. Cht. 3322 TD 3328'	

COMPLETED

County Rice Elev. 1622
 Sec. 33 Twp. 20 Rge. 7W
 Company Francis Raymond
 Farm Name Zwick No. 1

TOPS	DEPTH	LOG	DATUM
Anh.			
TP.			
H.	<u>2694</u>		
Tr.			
Dg.	<u>2734</u>		
BL.	<u>2854</u>		
L.	<u>2879</u>		<u>1257</u>
K.C.			
B.K.C.			
Ce.			
C. <u>shly</u>	<u>3313</u>		<u>1691</u>
M. <u>cg ch</u>	<u>3322</u>		<u>1700</u>
M.			
K.			
Mz.			
Mq.			
V.			
S.			
S.			
A.			
R.			
PE.			
G.			
T.D.	<u>3328</u>		

Loc. in Sec. _____

SW SW NW

Geol. _____

Contr. _____

Salina

Pool _____

Wherry

COMPLETE

Date Comm. 3-10-56

APR 11 1956

8" @ 228/150 DST 3126-35 open 1 hr.

rec. 50' socm 20' mud 20' sw

950/20" 5¹/₂" @ 3324/55 CO to 3328

DD 3342 Frac FU 2000' fluid

S/ 10 bo 10 bwph 6 hr. Comp. 25 bopd

8 bw

County Rice Elev. _____
 Sec. 33 Twp. 20 Rge. 7W
 Company Francis Raymond
 Farm Name Zwick No. 1

TOPS	DEPTH	LOG	DATUM	Loc. in Sec.
Anh.				SW SW NW
TP.				
H.				
Tr.				
Dg.				
BL.				
L.				Geol.
K.C.				Contr.
B.K.C.				Salina
Ce.				Pool
C.				Wherry
M.				
M.				
K.				
Mz.				
Mq.				
V.				
S.				
S.				
A.				
R.				
PE.				
G.				
T.D.				

Date Comm. 3-10-56 MAR 14 1956

8" @ 228/150 drlg. 1525

[Large red handwritten 'X' mark across the bottom section]