

Rice

KANSAS

SECTION 33 TOWNSHIP 20 RANGE 7W

WELL NO. #1 Zwick "A"

COMPANY Francis Raymond

NORTH

0							

WEST

EAST

SOUTH

Rice

KANSAS

SEC.

TWP.

R.

33

20

7W

WELL NO.

#1 Zwick "A"

FARM

COMPANY

Francis Raymond

CONTRACTOR

Murfin


Ft. from N. Line

Ft. from S. Line

Ft. from E. Line

Ft. from W. Line

NW NW SW

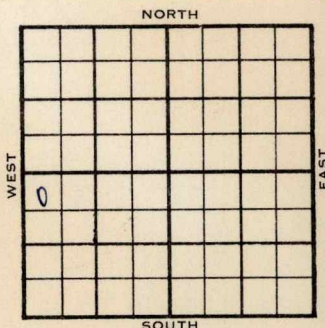

1956

ELEVATION

1621 DF

REPORT

4-25

Comm. 4-20-56

8" @ 231

Drlg. 1800

5-23

5½" @ 3338 w/150

CO 3339

DD 3356

S/ ½ boph, 30% wtr.

S/ 1¼ bfph, 50% wtr.,

FU 1650' fluid, 12 hrs.

P/ 18 bopd, 15 bwpd.

H. 2694', Dg. 2736', BL. 2856',

L. 2878', BKC 3222', C. Sh. 3317',

Cg. Cht 3338'

TD 3339'

COMPLETED

County Rice Elev. 1621 DF
 Sec. 33 Twp. 20 Rge. TW
 Company Francis Raymond
 Farm Name Zwick "A" No. 1

TOPS	DEPTH	LOG	DATUM	Loc. in Sec.
Anh.				NW NW SW
TP.				
H.	2694			
Tr.				
Dg.	2736			
Bl.	2856			
L.	2878			Geol.
K.C.				
B.M.C.	3222			Contr.
Ce.				
C. <u>5h</u>	3317			Murfin
M. <u>cgcht</u>	3338			
M.				Pool
K.				
Mz.				
Mo.				
V.				
S.				
S.				
A.				
R.				
PE.				
G.				
TD	3339			



Date Comm. 4-20-56 MAY 23 1956

8" @ 231 drlg. 1800 MAY 2 '56 5 1/2 @

3338/150 MAY 9 '56 CO 3339 DD

3356 TD & 1/2 BOPh 30%

wt Frac & 14 BFPh 50%

wt FU 1650' Fluid 12 hrs.

POP MAY 16 '56 MAY 23 '56 P. 18 BOPd

+ 15 BWPd.

County Rice Elev. _____
 Sec. 33 Twp. 20 Rge. 7W
 Company Francis Raymond
 Farm Name Zwick "A" No. 1

TOPS	DEPTH	LOG	DATUM
Anh.			
TP.			
H.			
Tr.			
Dg.			
Bl.			
L.			
K.C.			
B.K.C.			
Ce.			
C.			
M.			
M.			
K.			
Mz.			
Me.			
V.			
S.			
S.			
A.			
R.			
Pe.			
G.			
Ed.			

Loc. in Sec.

NW NW SW

Geol.

Contr.

Murfin

Pool

FIRST REPORT

0

APR 25-56

Date Comm. 4-20-568" @ 231 drlg. 1800

2201 S. YAN

J. G. J.

12