


McPherson

Form 51-5M-2-29-34703

Map No. **KANSAS** Sec. *33* Twp. *20* R. *3rd*

Well No. *3rd McCurdy* Farm
Senclair O&G Company

NORTH

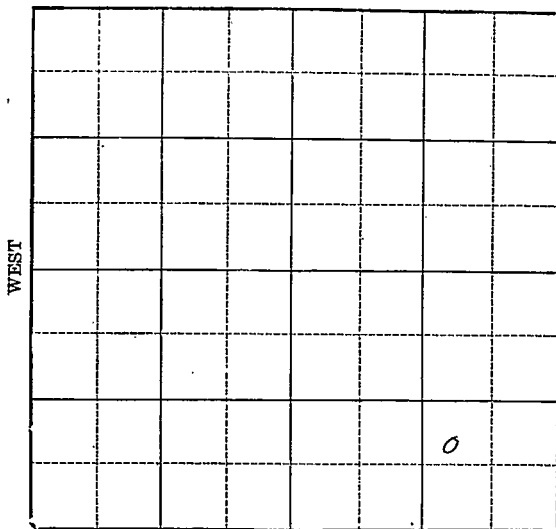

SOUTH

Location _____
Drilling Remarks _____

Rig Up _____
Drilling Remarks _____

RECORD

PRODUCTION

Cased _____ in. _____ ft.
Sand _____
Gas _____
Oil _____
Total Depth _____


1st 24 hrs. Nat. _____
1st 24 hrs. after shot _____
Gas _____ cu. ft. _____
Dry Hole _____
Abandoned _____

McPherson

Map No. **KANSAS** Sec. *33* Twp. *20* R. *3^w*

Well No. *3 - McCurdy* Farm
Sinclair Oil Company

NORTH

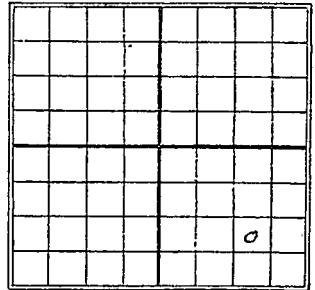

_____ Ft. from N. Line

805 Ft. from S. Line

990 Ft. from E. Line

1930 Ft. from W. Line

Date

REPORT

Date	REPORT
<i>6/4</i>	<i>Bldg mcg</i>
<i>6/11</i>	<i>hldg. 9149'</i>
<i>6/18</i>	<i>" 800'</i>
<i>6/25</i>	<i>" 3020'</i>
	<i>Top Chat 2950'</i>
<i>7/2</i>	<i>Viola 3217'</i>
	<i>Slg. out 3231'</i>
<i>7/9</i>	<i>Wilcox 3257-90</i>
	<i>TD 3290</i>
	<i>swab 330 lbe</i>
	<i>Comp.</i>

M. Merion

Map No. KANSAS Sec. 33 Twp. 20 R. 3W

43
Well No. 3 M^cCurdy

Pine Hill Oil & Gas Company

Contractor

SECTION PLAT

_____ Ft. from N. Line
805 Ft. from S. Line
990 Ft. from E. Line
_____ Ft. from W. Line

			0

FIRST REPORTS

Location _____

Rig up _____

Drilling and Remarks:

Building rig

RECORD

Cased _____ in., _____ ft.

Sand _____

Gas _____

Oil _____

Total Depth _____

PRODUCTION

1st 24 hrs. Nat. _____

1st 24 hrs. after shot _____

Gas _____ Cu. Ft.

Dry Hole _____

Abandoned _____

Date

JUN 4 1930

19

S. J. LEWIS

Scout

W. H. Person

Map No. **KANSAS** Sec. *33* Twp. *20* R. *3W*
43

Well No. *3 McCurdy*

Senclair O & S. Company

Contractor

SECTION PLAT

..... Ft. from N. Line

805 Ft. from S. Line

990 Ft. from E. Line

..... Ft. from W. Line

COMPLETED

Location.....

Rig up.....

Drilling and Remarks:

W. loc # 3257-3295

sway 330 yds

RECORD

Cased..... in., ft.

Sand.....

Gas.....

Oil.....

Total Depth *3290*

PRODUCTION

1st 24 hrs. Nat.....

1st 24 hrs. after shot.....

Gas..... Cu. Ft.

Dry Hole.....

Abandoned.....

Date

JUL 9 1930

S. J. LEWIS Scout