


*McPherson*

Form 51-5M-11-31-Palace

Map No. **KANSAS** Sec. *33* Twp. *20* R. *3<sup>10</sup>*

Well No. *7 McCurdy* Farm  
*Linclair-Pringle* Company

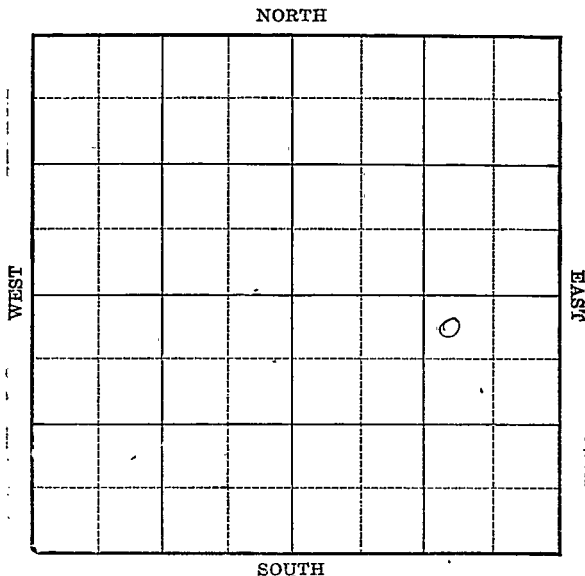

Location \_\_\_\_\_

Drilling Remarks \_\_\_\_\_

\_\_\_\_\_

\_\_\_\_\_

**RECORD**

Cased \_\_\_\_\_ in. \_\_\_\_\_ ft.

Sand \_\_\_\_\_

Gas \_\_\_\_\_

Oil \_\_\_\_\_

Total Depth \_\_\_\_\_

Rig Up \_\_\_\_\_

Drilling Remarks \_\_\_\_\_

\_\_\_\_\_

\_\_\_\_\_

**PRODUCTION**

1st 24 hrs. Nat. \_\_\_\_\_

1st 24 hrs. after shot \_\_\_\_\_

Gas \_\_\_\_\_ cu. ft. \_\_\_\_\_

Dry Hole \_\_\_\_\_

Abandoned \_\_\_\_\_

*McPherson*

Map No. KANSAS Sec. 33 Twp. 20 R. 30

Well No. 7 McQuady Farm


Sinclair Prairie Company

320' Ft. from N. Line

\_\_\_\_\_ Ft. from S. Line

990' Ft. from E. Line

\_\_\_\_\_ Ft. from W. Line

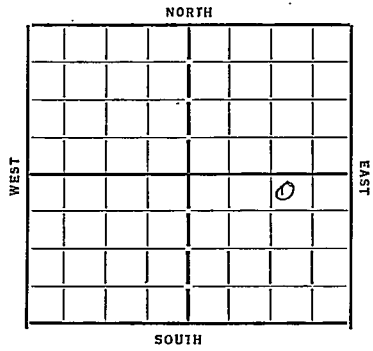

Date 7/23

REPORT

11/22 Ponds  
11/29 \_\_\_\_\_  
12/6 Drig 1000 15" at 209  
12/12 " 2570  
12/27 Chat 2963 8" 2965  
Viola 3250  
Drig 3263  
1/11 e.o.r 8" at 3263  
1/17 Wilcox 3288 - T.D. 3327  
700' fluid in hole  
1/24 \_\_\_\_\_  
1/31 Tubing  
2/7 Wilcox 3288 TD 3327 shot  
20 gte 619 Pot.

COMPLETED

McPherson  
 Map No. 43 Sec. 33 Twp. 20 R. 3W

Well No. 7- McCurdy

Amilair-prairie Company

Contractor

**FIRST REPORTS**

**SECTION PLAT**

330 Ft. from N. Line

..... Ft. from S. Line

990 Ft. from E. Line

..... Ft. from W. Line

			0

Location.....

Rig up.....

Drilling and Remarks:

*ponds*

**RECORD**

Cased..... in., ..... ft.

Sand.....

Gas.....

Oil.....

Total Depth.....

**PRODUCTION**

1st 24 hrs. Nat.....

1st 24 hrs. after shot.....

Gas..... Cu. Ft.

Dry Hole.....

Abandoned.....

Date

11-22-33 192 *O. Manschuet* Scout

Map No. 43 Sec. 33 Twp. 20 R. 3W

Well No. 7 McCurdy

Sinclair Prairie Company

Contractor

**COMPLETED**

SECTION PLAT

330 Ft. from N. Line  
 \_\_\_\_\_ Ft. from S. Line  
990 Ft. from E. Line  
 \_\_\_\_\_ Ft. from W. Line

			0

Location \_\_\_\_\_

Rig up \_\_\_\_\_

Drilling and Remarks:

shot 20 gts

619  
pat

RECORD

Cased \_\_\_\_\_ in., \_\_\_\_\_ ft.  
 Sand Willcot 3788  
 Gas \_\_\_\_\_  
 Oil \_\_\_\_\_  
 Total Depth 3327

PRODUCTION

1st 24 hrs. Nat. \_\_\_\_\_  
 1st 24 hrs. after shot \_\_\_\_\_  
 Gas \_\_\_\_\_ Cu. Ft.  
 Dry Hole \_\_\_\_\_  
 Abandoned \_\_\_\_\_

Date

2-7-34 1934 O. Marmischer Scout