

Mc Pherson


Form 51-5M-11-31-Palace

Map No. KANSAS Sec. 33 Twp. 20 R. 3 W

Well No. 8 Mc Curdy Farm

Sinclair - Prairie Company

NORTH

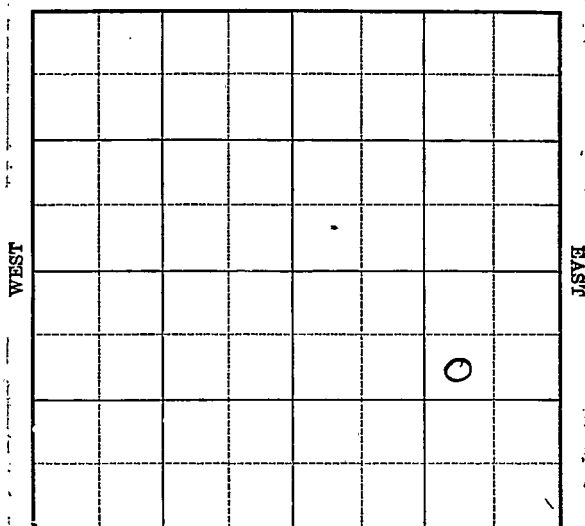

SOUTH

Location

Drilling Remarks

Rig Up

Drilling Remarks

RECORD

Cased in. ft.

Sand

Gas

Oil

Total Depth

PRODUCTION

1st 24 hrs. Nat.

1st 24 hrs. after shot

Gas cu. ft.

Dry Hole

Abandoned

Mc Pherson

Map No. KANSAS Sec. 33 Twp. 20 R. 3W

Well No. 8 Mc Curdy Farm


Sinclair - Prairie Company

990 Ft. from N. Line

 Ft. from S. Line

990 Ft. from E. Line

 Ft. from W. Line

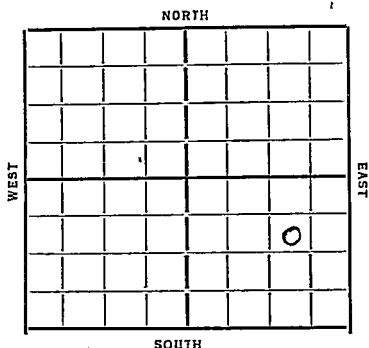

Date 7/23/4

REPORT

2/7 Rotary Rig
2/14 Delg 480
2/23 " 2515 KC Lime 2295
3/1 " 3080 Chat 2955
3/8 Viola 3193 6" 3220 Rust
3/15 Wilcox 3278 S.O. 3309
YD 3314 shot 20 gte CO
3/22 Shot 10 Bbls for hr.
3/28 Wilcox 3278 YD 3314
shot 20 gte 511 Bbls.

COMPLETED

Map No. 43 Sec. 33 Twp. 20 R. 3WWell No. 8-McCurrySinclair - prairie Company

Contractor

FIRST REPORTS

SECTION PLAT

990 Ft. from N. Line

Ft. from S. Line

990 Ft. from E. Line

Ft. from W. Line

			0

Location

Rig up

Drilling and Remarks:

Rotary Rig

RECORD

Cased in., ft.

Sand

Gas

Oil

Total Depth

PRODUCTION

1st 24 hrs. Nat.

1st 24 hrs. after shot

Gas Cu. Ft.

Dry Hole

Abandoned

Date

2-7-34

192

O. Mansfield Scout

Map No. 43 Sec. 33 Twp. 20 R. 3ⁿWell No. 8 - McCurdyAmclair prairie Company

Contractor

COMPLETED

SECTION PLAT

990 Ft. from N. Line

Ft. from S. Line

990 Ft. from E. Line

Ft. from W. Line

			0

Location

Rig up

Drilling and Remarks:

20 qts.511 lbs

RECORD

Cased in., ft.Sand Wilcox 3278

Gas

Oil

Total Depth 3314

PRODUCTION

1st 24 hrs. Nat. 1st 24 hrs. after shot Gas Cu. Ft.

Dry Hole

Abandoned

Date

3/28/34 O. Mammlich 192 Scout