
McPherson

Form 51—5M—2-29—34703

Map No KANSAS Sec. 33 Twp. 20 R. 3W

Well No. 1-G Stuckus Farm

Gypsy Oil Company

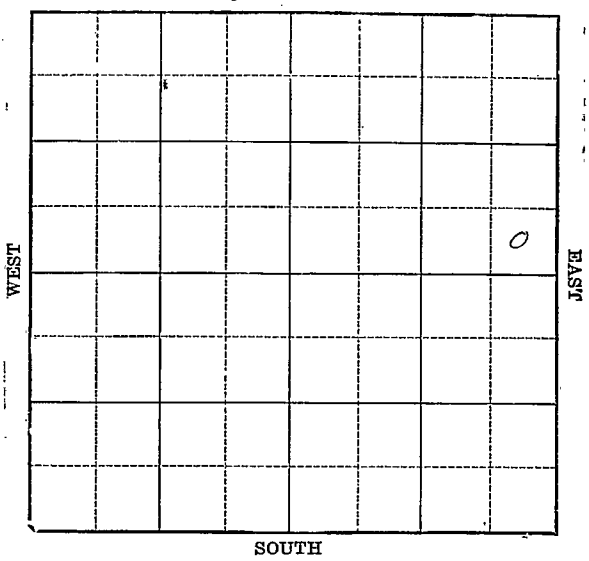

Location

Drilling Remarks

Rig Up

Drilling Remarks

RECORD

Cased ____ in. ____ ft.

Sand

Gas

Oil

Total Depth

PRODUCTION

1st 24 hrs. Nat.

1st 24 hrs. after shot

Gas ____ cu. ft.

Dry Hole

Abandoned

McPherson


Form 252A—5M—11-29—38055

Map No. KANSAS Sec. 33 Twp. 20 R. 3w

Well No. 1 Stucky Farm

Gypsy Oil Company

NORTH

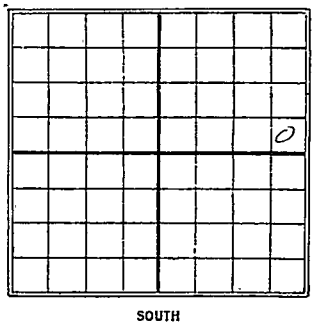

____ Ft. from N. Line

330 Ft. from S. Line

330 Ft. from E. Line

____ Ft. from W. Line

1930

Date	REPORT
7/30	Rud
8/6	Drlg. 1460'
8/13	" 2900'
8/20	Lost 3369
8/27	Oil 3406-08
	1000 - 4 hrs. swab
	520 bbls 14 hrs.
9/3	Top Wilcox 3406-16
	T.D. 3424
	Swab 630 bbls

Form 26 - 1M Bks. - 2-29 43


Map No. KANSAS Sec. 33 Twp. 20 R. 8W

Well No. 1 Stuckey

Gypsy Oil Company

Contractor

SECTION PLAT

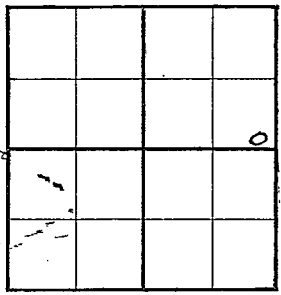

____ Ft. from N. Line

330 Ft. from S. Line

330 Ft. from E. Line

____ Ft. from W. Line

FIRST REPORTS

Location ____

Rig up ____

Drilling and Remarks:

Rigging up

Rotary

RECORD

Cased ____ in., ____ ft.

Sand ____

Gas ____

Oil ____

Total Depth ____

PRODUCTION

1st 24 hrs. Nat. ____

1st 24 hrs. after shot ____

Gas ____ Cu. Ft.

Dry Hole ____

Abandoned ____

Date

JUL 30 1930

19 ____

S. J. LEWIS Scout

Form 26—1M Pks 6-29

Map No. KANSAS Sec. 22 Twp. 20 R. 9W


43

Well No. 1 Stuckey

Gypsy Oil Company

J. J. Contractor

SECTION PLAT

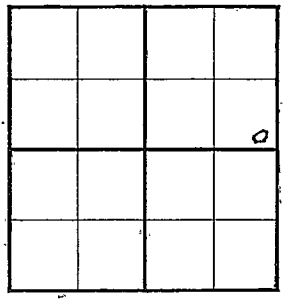

____ Ft. from N. Line

330 Ft. from S. Line

330 Ft. from E. Line

____ Ft. from W. Line

COMPLETED

Location ____

Rig up ____

Drilling and Remarks:

Wich 8406-16

swd 8-6-30 8406

RECORD

Cased ____ in., ____ ft.

Sand ____

Gas ____

Oil ____

Total Depth 8424

PRODUCTION

1st 24 hrs. Nat. ____

1st 24 hrs. after shot ____

Gas ____ Cu. Ft.

Dry Hole ____

Abandoned ____

Date SEP 3 1930

19

S. J. LEWIS Scout