
McPherson

Form 51—5M—2-29—34703

Map No. KANSAS Sec. 33 Twp. 20 R. 3W

Well No. 2 Stuckey Farm

Gypsy Oil Company

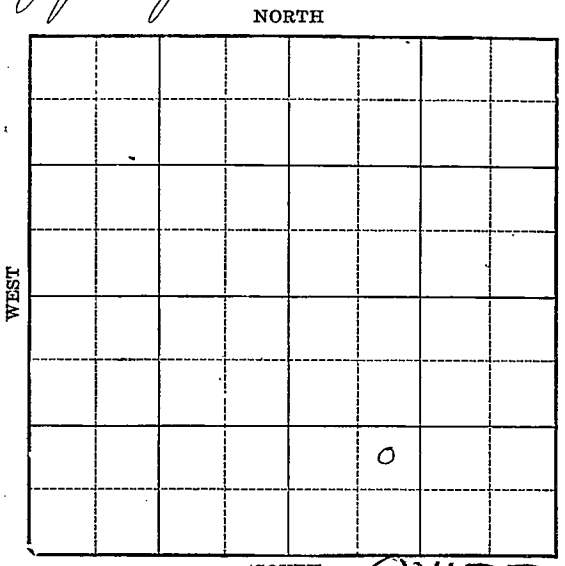

OWDD

Location

Drilling Remarks

Rig Up

Drilling Remarks

RECORD

Cased ____ in. ____ ft.

Sand

Gas

Oil

Total Depth

PRODUCTION

1st 24 hrs. Nat.

1st 24 hrs. after shot

Gas ____ cu. ft.

Dry Hole

Abandoned


Mc Pherson

Form 252A—5M—11-29—38055

Map No. KANSAS Sec. 33 Twp. 20 R. 3 W

Well No. 2-1 Stuckey Farm

Gypsy Oil Company

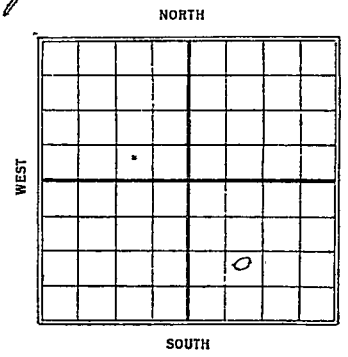

_____ Ft. from N. Line

990 Ft. from S. Line

_____ Ft. from E. Line

990 Ft. from W. Line

1930

Date	REPORT
6/4	Rig
6/11	Drlg 700'
6/18	" 2585'
6/25	" 3090'
7/2	Viola 3227'
	8" - 3230 - show
	oil 3234 - drlg.
7/9	Wilcox 3256-88
	TD 3288
	Pump 400 bbl
	Comp
1931	OWDD
4/29	Old T.D. 3288' Valcor
	Sel lime 3330-46
	Swab 65 bbl 3 hr
	May deepen
5/6	T.D. 3356
	Pump 265 bbl 12 hrs
5/13	Sell lime 3330-56
	T.D. 3356
	Made 695 bbl oil
	Comp.

Form 26—TM Bks. 2-29

Map No. KANSAS Sec. 33 Twp. 28 R. 3 W


43

Well No. 2 Stuckey

Gypsy Oil Co. Company

Contractor

SECTION PLAT

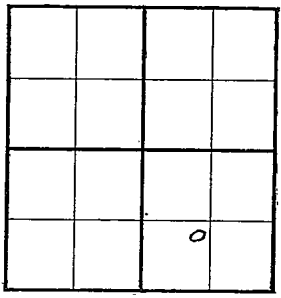

____ Ft. from N. Line

990 Ft. from S. Line

____ Ft. from E. Line

990 Ft. from W. Line

FIRST REPORTS

Location ____

Rig up ____

Drilling and Remarks:

Rig R & Tools

RECORD

Cased ____ in., ____ ft.

Sand ____

Gas ____

Oil ____

Total Depth ____

PRODUCTION

1st 24 hrs. Nat. ____

1st 24 hrs. after shot ____

Gas ____ Cu. Ft.

Dry Hole ____

Abandoned ____

Date

JUN 4 1930

19

S. J. LEWIS Scout

Form 26—1M Blks 8-28

Map No. KANSAS Sec. 33 Twp. 20 R. 8 W


43

Well No. 2 Stuckey

Gypsy Oil Company

Contractor

SECTION PLAT

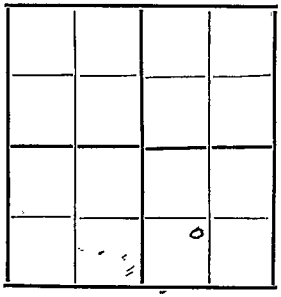

Ft. from N. Line

990 Ft. from S. Line

Ft. from E. Line

990 Ft. from W. Line

COMPLETED

Location

Rig up

Drilling and Remarks:

Wilco 8206-88

Pump 400 Bbls

RECORD

Cased in., ft.

Sand

Gas

Oil

Total Depth 3290

PRODUCTION

1st 24 hrs. Nat.

1st 24 hrs. after shot

Gas Cu. Ft.

Dry Hole

Abandoned

Date

JUL 9 1930 192

S. J. LEWIS Scout

Form 26—1M Bks.—9-26

McPherson

Map No. KANSAS Sec. 33 Twp. 20 R. 3 W

43

Well No. 2 E. Stuckey

Gypsy Oil Co Company

Contractor

FIRST REPORTS

Ft. from N. Line


990 Ft. from S. Line

Ft. from E. Line

990 Ft. from W. Line

old hole Deeper

SECTION PLAT

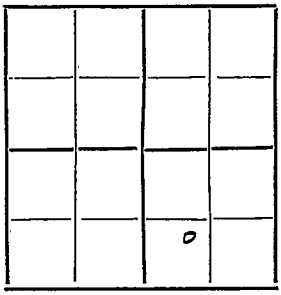

Location

old Record Wilcox 3356-90

Rig up

Drilling and Remarks:

Silt lime 3330-44

Worked 65 hrs 3 hrs

may Deepen.

RECORD

Cased in., ft.

Sand

Gas

Oil

Total Depth

PRODUCTION

1st 24 hrs. Nat.

1st 24 hrs. after shot

Gas Cu. Ft.

Dry Hole

Abandoned

Date

APR 2 9 1931

192

CHAS. L. SHERWOOD

Scout

Form 26—1M Bks. 9-28 McPherson

43 KANSAS

Map No. ..... Sec. 33 Twp. 20 R. 3 W

Well No. 2 E. Stucky

Gypsy Oil Co Company

..... Contractor

COMPLETED


..... Ft. from N. Line

990 Ft. from S. Line

..... Ft. from E. Line

990 Ft. from W. Line

SECTION PLAT

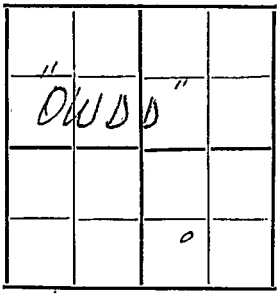

Location .....

Rig up .....

Drilling and Remarks:

695 Blo.

RECORD

Cased ..... in., ... ft.

Sand Silic 3330-3356

Gas .....

Oil .....

Total Depth 3356

PRODUCTION

1st 24 hrs. Nat. .....

1st 24 hrs. after shot .....

Gas ..... Cu. Ft.

Dry Hole .....

Abandoned .....

Date

MAY 13 1931 192.....

CHAS. L. SHERWOOD Scout