
McPherson

Form 51—5M—2-29—34703

Map No. KANSAS Sec. 33 Twp. 20 R. 3W

Well No. 1—McCurdy Farm

Sinclair Oil Co Company

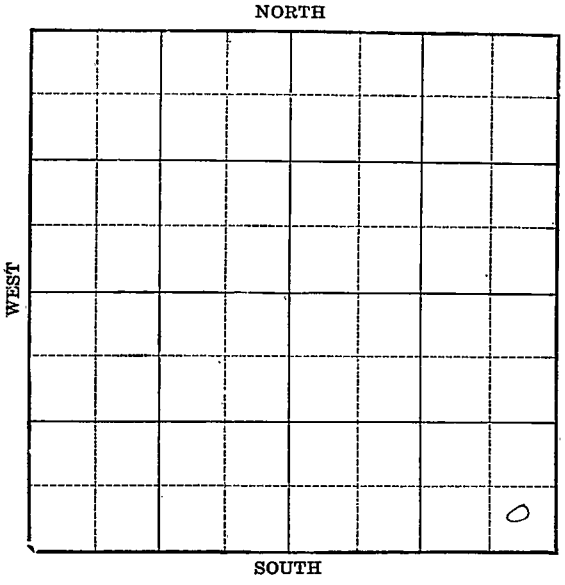

Location

Drilling Remarks

Rig Up

Drilling Remarks

RECORD

Cased ____ in. ____ ft.

Sand

Gas

Oil

Total Depth

PRODUCTION

1st 24 hrs. Nat.

1st 24 hrs. after shot

Gas ____ cu. ft.

Dry Hole

Abandoned

Mc Pherson

Form 252A—5M—11-29—38055

Map No. KANSAS Sec. 33 Twp. 20 R. 3W

Well No. 1- Mc Curdy Farm

Sinclair O & G Company

NORTH

WEST EAST

SOUTH

____ Ft. from N. Line

330 Ft. from S. Line

330 Ft. from E. Line

____ Ft. from W. Line

1930

Date	REPORT
5/21	Loc
5/28	Mrlg. 690'
6/4	" 2030'
6/11	" 2575'
6/18	" 3095'
	Top Chat 2995'
6/25	Viola 3273'
	Wilcox 3298'
	Mrlg. 3301'
	Hole filling up.
7/2	Top Viola 3273
	" Wilcox 3298
	Base " 3369
	Dolc lime 3369-72
	TD 3372
	swab 972 Gbl oil
	Corp.

Form 25 ~~10M Bla c-9-28~~


Map No. KANSAS Sec. 33 Twp. 20 R. 3 W

Well No. 43 J. M. McCurdy

Sinclair Oil & Gas Company

Contractor

SECTION PLAT

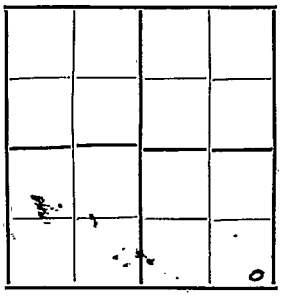

..... Ft. from N. Line

330 Ft. from S. Line

330 Ft. from E. Line

..... Ft. from W. Line

FIRST REPORTS

Location

Rig up

Drilling and Remarks:

RECORD

Cased ..... in., ... ft.

Sand

Gas

Oil

Total Depth

PRODUCTION

1st 24 hrs. Nat.

1st 24 hrs. after shot

Gas ..... Cu. Ft.

Dry Hole

Abandoned

Date

MAY 21 1930

192

S. J. LEWIS Scout

Form 26 KM Bks 2-29

Map No. KANSAS Sec. 33 Twp. 21 R. 2 W


43

Well No. 1 Mc Cuaday

Sinclair Oil & Gas. Company

Contractor

SECTION PLAT

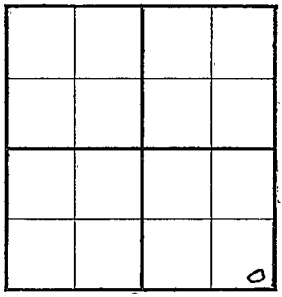

____ Ft. from N. Line

330 Ft. from S. Line

330 Ft. from E. Line

____ Ft. from W. Line

COMPLETED

Location

Rig up

Drilling and Remarks:

Viola 3273

Wilcox 3288-3369

Oil line 3369-72

Total Depth 3372

RECORD

Cased ____ in., ____ ft.

Sand

Gas

Oil

PRODUCTION

1st 24 hrs. Nat.

1st 24 hrs. after shot

Gas ____ Cu. Ft.

Dry Hole

Abandoned

Date

JUL 2 1930

S. J. LEWIS Scout