
Mc Pherson

Form 51—5M—2-29—34703

Map No. KANSAS Sec. 33 Twp. 20 R. 3W

Well No. H- Mc Cuddy Farm

Sinclair Oil & G Company

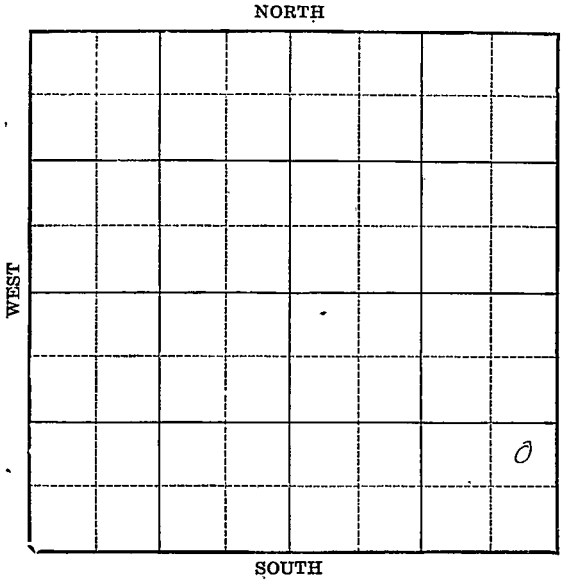

Location

Drilling Remarks

Rig Up

Drilling Remarks

RECORD

Cased ____ in. ____ ft.

Sand

Gas

Oil

Total Depth

PRODUCTION

1st 24 hrs. Nat.

1st 24 hrs. after shot

Gas ____ cu. ft.

Dry Hole

Abandoned


Mc Pherson

Form 252A—5M—11-29—38055

Map No. KANSAS Sec. 33 Twp. 20 R. 3W

Well No. #1 Mc Curdy Farm

Sinclair O & G Company

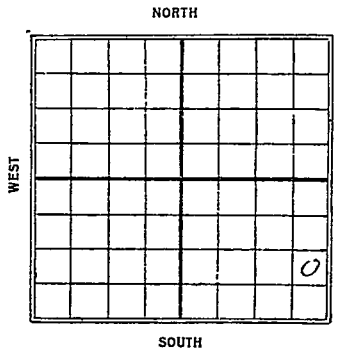

_____ Ft. from N. Line

940 Ft. from S. Line

330 Ft. from E. Line

_____ Ft. from W. Line

1930

Date	REPORT
6/25	Rig up.
7/2	Ldg. 1770'
7/9	" 2464'
7/16	" 3266'
	Top Viola 3260'
7/23	Viola 3269 - (SLM)
	T.D. 3275. Ldg. out
7/30	Wilcox 3292 - 3316
	TD 3316
	Swab 114 BBL oil
	Comp.

Form 26—1M Blks. 9-28

Mc Pherson

Map No. KANSAS Sec. 23 Twp. 20 R. 8 W


43

Well No. 4 Mc Cuddy

Sinclair O & G Company

Contractor

SECTION PLAT

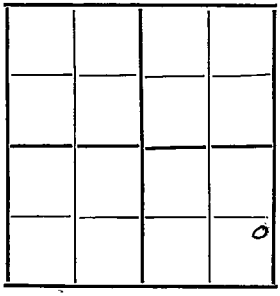

.....Ft. from N. Line

990 Ft. from S. Line

330 Ft. from E. Line

.....Ft. from W. Line

FIRST REPORTS

Location.....

Rig up.....

Drilling and Remarks:

Rigging up

RECORD

Cased.....in., ...ft.

Sand.....

Gas.....

Oil.....

Total Depth.....

PRODUCTION

1st 24 hrs. Nat.....

1st 24 hrs. after shot.....

Gas.....Cu. Ft.

Dry Hole.....

Abandoned.....

Date

JUN 25 1930

192...

S. J. LEWIS Scout

Form 26 1M Blks. 2-29




Well No. 4 McCurdy

Sinclair Oil & Gas Company

Contractor

SECTION PLAT

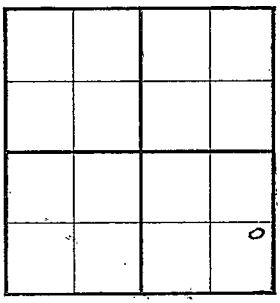

____ Ft. from N. Line

990 Ft. from S. Line

330 Ft. from E. Line

____ Ft. from W. Line

COMPLETED

Location

Rig up

Drilling and Remarks:

Wilcox 3292-3316

Shot 8/11/43 8/16

RECORD

Cased ____ in., ____ ft.

Sand

Gas

Oil

Total Depth 3316

PRODUCTION

1st 24 hrs. Nat.

1st 24 hrs. after shot

Gas ____ Cu. Ft.

Dry Hole

Abandoned

Date

JUL 30 1943

S. J. LEWIS Scout