
Mc Pherson

Form 51—5M—2-29—34703

Map No. KANSAS Sec. 33 Twp. 20 R. 3w

Well No. 5-1 Mc Gurdy Farm

Sinclair O&S Co. Company

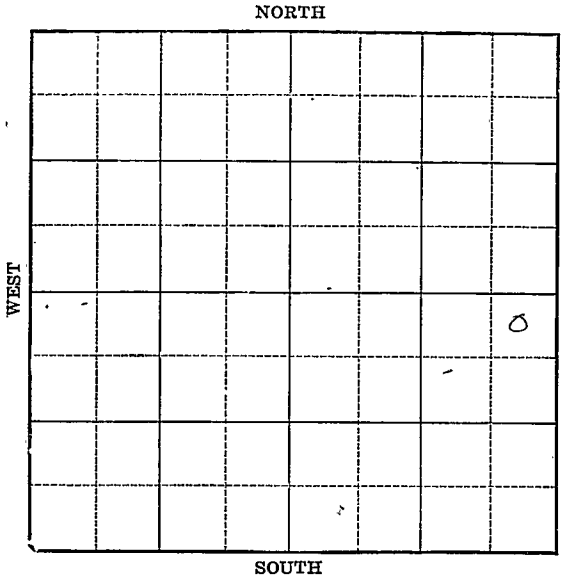

Location

Drilling Remarks

Rig Up

Drilling Remarks

RECORD

Cased ____ in. ____ ft.

Sand

Gas

Oil

Total Depth

PRODUCTION

1st 24 hrs. Nat.

1st 24 hrs. after shot

Gas ____ cu. ft.

Dry Hole

Abandoned

Form 252A—5M—11-29—38055 McPherson

Map No. KANSAS Sec. 33 Twp. 20 R. 3W

Well No. 5 McCurdy Farm

Sinclair O&G Company


330 Ft. from N. Line

Ft. from S. Line

330 Ft. from E. Line

Ft. from W. Line

1930

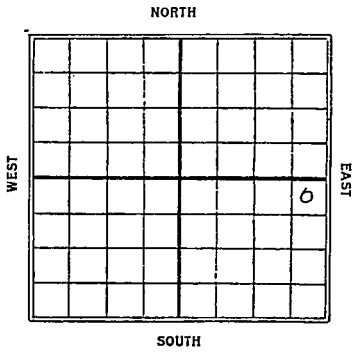

Date	REPORT
7/30	Rig (Rotary)
8/6	Drlg. 648'
8/13	" 2440'
8/20	6"- 3318' Rush
8/27	Viola 3320-25
9/3	Wilcox 3340-71
	Swab 1270 bbls

Form 26—1M Blks—2-29 43


Map No. KANSAS Sec. 27 Twp. 20 R. 3W

Well No. 5 McQuadday

Sinclair Oil & Gas Company

Contractor

SECTION PLAT

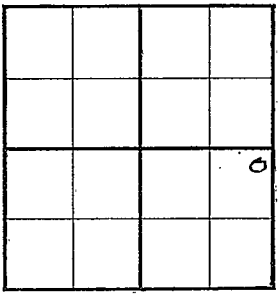

330 Ft. from N. Line

_____ Ft. from S. Line

330 Ft. from E. Line

_____ Ft. from W. Line

FIRST REPORTS

Location_____

Rig up_____

Drilling and Remarks:

Rig Rotary

RECORD

Cased_____ in., _____ ft.

Sand_____

Gas_____

Oil_____

Total Depth_____

PRODUCTION

1st 24 hrs. Nat._____

1st 24 hrs. after shot_____

Gas_____ Cu. Ft.

Dry Hole_____

Abandoned_____

Date

JUL 30 1930 19

S. J. LEWIS Scout

Form 25—1M Blk. 42-29


Map No. KANSAS Sec. 33 Twp. 30 R. 8W

43


Contractor

SECTION PLAT

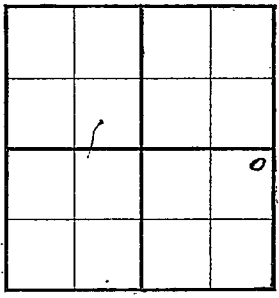

330 Ft. from N. Line

Ft. from S. Line

330 Ft. from E. Line

Ft. from W. Line

COMPLETED

Location

Rig up

Drilling and Remarks:

Wilcox 3346 : 71

Iowa 8 1270 Sh

RECORD

Cased in., ft.

Sand

Gas

Oil

Total Depth 3371

PRODUCTION

1st 24 hrs. Nat.

1st 24 hrs. after shot

Gas Cu. Ft.

Dry Hole

Abandoned

Date

SEP 3 1930

S. J. LEWIS Scout