

McPherson


Form 51-5M-11-31-Palace

Map No. **KANSAS** Sec. **33** Twp. **20** R. **3W**

Well No. **3 Stucky** Farm

Gypsy Oil Company

NORTH

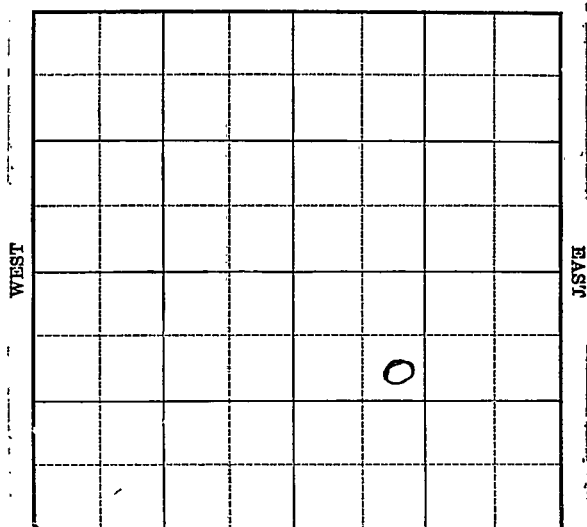

SOUTH

Location

Drilling Remarks

Rig Up

Drilling Remarks

RECORD

Cased in. ft.

Sand

Gas

Oil

Total Depth

PRODUCTION

1st 24 hrs. Nat.

1st 24 hrs. after shot

Gas cu. ft.

Dry Hole

Abandoned

Mc Pherson

Map No. KANSAS Sec. 33 Twp. 20 R. 3^w

Well No. 3 Stucky Farm


Gypsy oil Company

990 Ft. from N. Line

_____ Ft. from S. Line

_____ Ft. from E. Line

990 Ft. from W. Line

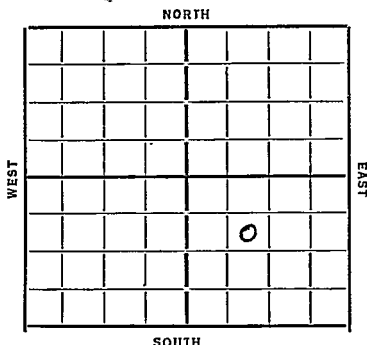

Date
1934

REPORT

2/7 Location

2/14 Rig

2/23 Drly 320

3/1 " 1912

3/8 " 2420

3/15 " 3058 Chst 2998

3/22 _____

3/29 Simpson 3296 Hilcox 3301

Drly 3372

4/5 Siliceous 3372 50. 3372-75TD

4/18 Siliceous 3372 TD 3375

Pump 582 BBlb oil

COMPLETED

Map No. 43 Sec. 33 Twp. 20 R. 3WWell No. 3 - StuckyGypsy Oil Company

Contractor

SECTION PLAT

FIRST REPORTS

990 Ft. from N. Line

Ft. from S. Line

Ft. from E. Line

990 Ft. from W. LineLocation ✓

Rig up

Drilling and Remarks:

RECORD

Cased _____ in., _____ ft.

Sand _____

Gas _____

Oil _____

Total Depth _____

PRODUCTION

1st 24 hrs. Nat. _____

1st 24 hrs. after shot _____

Gas _____ Cu. Ft.

Dry Hole _____

Abandoned _____

Date

5-7-34 192 O. Mannschub Scout

KANSAS


Contractor

COMPLETED

SECTION PLAT

		0	

990 Ft. from N. Line

_____ Ft. from S. Line

_____ Ft. from E. Line

990 Ft. from W. Line

Location _____

Rig up _____

Drilling and Remarks:

Pump582Whs oil

RECORD

Cased _____ in., _____ ft.

Sand siliceous 3372

Gas _____

Oil _____

Total Depth 3375

PRODUCTION

1st 24 hrs. Nat. _____

1st 24 hrs. after shot _____

Gas _____ Cu. Ft.

Dry Hole _____

Abandoned _____

Date

4-18-34₁₉ORVAL MANNSCHRECK
Scout