


Section 33 Township 20 Range 6-W

Well No. #1 Baker

Company Pulse et al

NORTH Wildcat

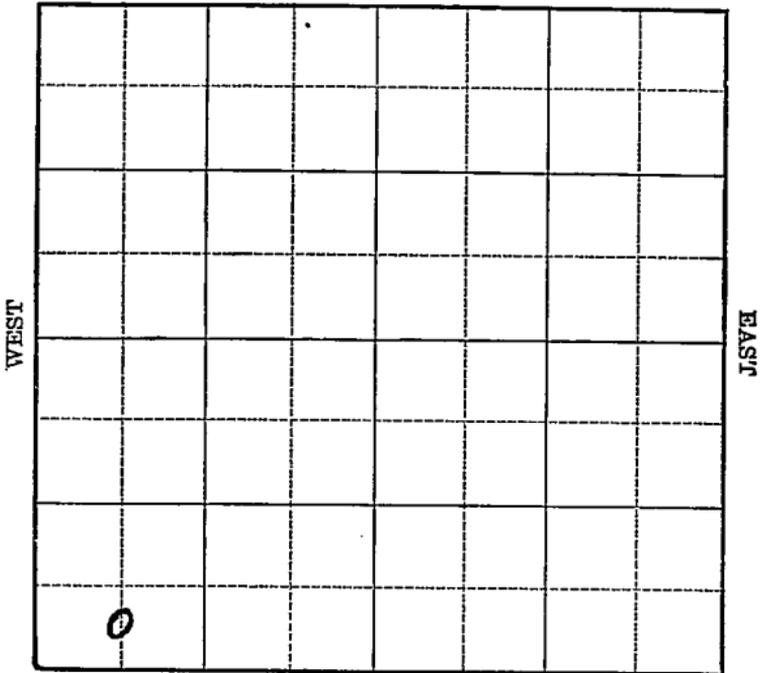

SOUTH

Map No. 48 Sec. 33 Twp. 20 R. 6WWell No. 1 BakerPulse etal Company

Contractor

FIRST REPORT

SECTION PLAT

C S L SW SW

 Ft. from N. Line330 Ft. from S. Line Ft. from E. Line660 Ft. from W. Line

WILDCAT

Location Rig up

Drilling and Remarks:

RUR

RECORD

Cased in., ft.Sand Gas Oil Total Depth

PRODUCTION

1st 24 hrs. Nat. 1st 24 hrs. after shot Gas Cu. Ft.Dry Hole Abandoned

Date

APR 2 - 1940 ₁₉

S. J. LEWIS Scout

Map No. 48 Sec. 33 Twp. 20 R. 6WWell No. 1 BakerPulse etal Company

Contractor

ABANDONED

C S L SW SW

_____ Ft. from N. Line

330 Ft. from S. Line

_____ Ft. from E. Line

660 Ft. from W. Line

WILDCAT

SECTION PLAT

Location _____

Rig up _____

Drilling and Remarks:

Cha 834245" C3426Water

RECORD

Cased _____ in., _____ ft.

Sand _____

Gas _____

Oil _____

Total Depth 3508

PRODUCTION

1st 24 hrs. Nat. _____

1st 24 hrs. after shot _____

Gas _____ Cu. Ft.

Dry Hole _____

Abandoned _____

Date

JUN 12 1940 19S. J. LEWIS Scout