

Rice KANSAS

Section 33 Township 20 Range 6 W

Well No. # 1 Fair

Company Sterling Drlg.

NORTH

			0				

WEST

EAST

SOUTH

Rice

KANSAS

Sec. 33 - Twp. 20 R. 6W

Well No. #1 Fair Farm

Sterling Drlg. Company

Sterling Drlg. Contractor


_____ Ft. from N. Line

330 Ft. from S. Line

330 Ft. from E. Line

_____ Ft. from W. Line

SE SE SW

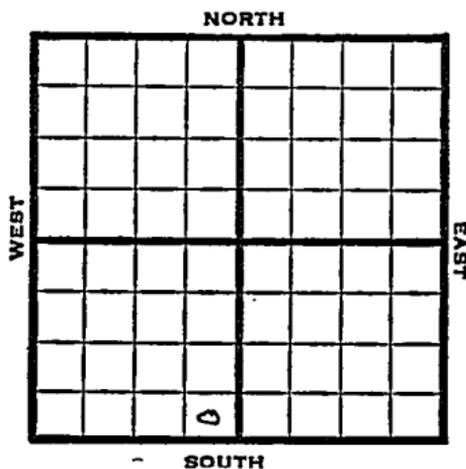

1952

Elev. 1627'

REPORT

3/19

Location

3/25

8" @ 127

Drlg. 2470'

4/1

Cong. 3412' Miss 3419'

RTD 3428' 5" @ 3421' WOC

4/9

MIGT

4/23

Spud 3-20-52

Oil Well TD 3463'

8" @ 127' Cong. 3412 Miss. 3419

TD 3428 5" @ 3421' CO to 3463

TD 3428 Hydro. S/ 3/4 boph

S/ 10 bfph 6 hr. FU 1380' fluid

8 hr. 30% wtr.

Comp. 25 bopd 40% wtr.

COMPLETED


County **Rice** State **Kansas**

Sec. **33** (Blk. Twp.) **20** (Sur. Rge.) **6W** Map No.

Operator **Sterling Drlg.**

Well No. **1** Farm **Fair**

Elev. Location **SE SE SW**

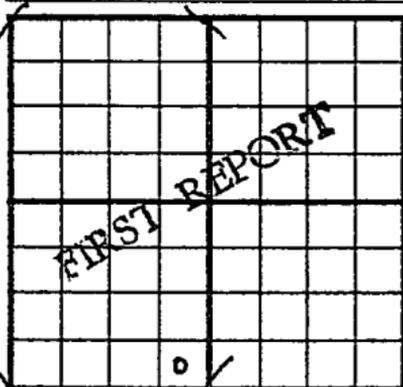

330 Ft. From **S** Line **SW**

330 Ft. From **E** Line Quarter

1st. Report **MAR 1.9 1952**

Completion

Remarks


Sterling Drlg. - Contr.

Spudding Date

Drlg. Data

Location

County Rice State Kansas
 Sec. 33 (Blk. 20) (Sur. 6W) (Twp.) 20 Map No.
 Operator Sterling Drlg.
 Well No. 1 Farm Fair
 Elev. 1627 Location SE SE SW

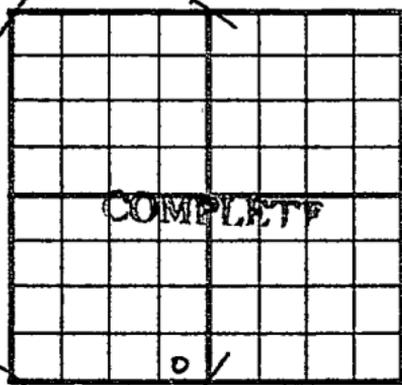

330 Ft. From S Line SW
330 Ft. From E Line Quarter
 Ist. Report
 Completion APR 23 1952
 Remarks
Sterling Drlg. - Contr.
 Spudding Date 3-20-52

Drlg. Data Oil well TD 3463
8" @ 127 Cong. 3412 Miss. 3419
TD 3428 5" @ 3421 CO to 3463
Hydro. S/ 3/4 boph S/ 10 bfph 6 hr.
FU 1380' fluid 8 hr. 30% water
Comp. 25 bopd 40% water

J. G. McGEHEE