

Well No. #1 Price

Company Virginia Drlg. Co.

NORTH

WEST

EAST

SOUTH

McPherson KANSAS
 SEC. 33 TWP. 20 R. 1W

WELL NO.

#1 Price FARM
 COMPANY

Virginia Drlg.
 CONTRACTOR

Co. Tools.

Wildcat


Ft. from N. Line

330 Ft. from S. Line

Ft. from E. Line

330 Ft. from W. Line

SW SW NW

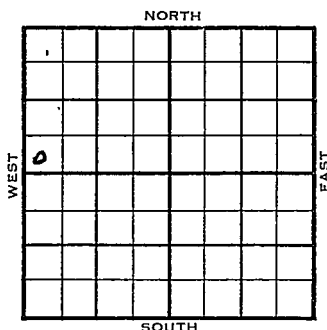


1954 ELEVATION 1523' REPORT

9/29 Location (will go by 10/1)

1955
1/19 Spud 10-21-54 - D&A
 TD 3570'
 8" @ 155'
 Mids 2943'
 DST 2955-68', opn 1 hr., gas in 30",
 rec. 10' mud, 1015#
 DST 2968-92', opn 1 hr., rec. 20' mud,
 0#
 DST 2997-3022', opn 1 hr., gas in 8",
 1,000,000 cfg, 90' mud, 60' MW, 915#
 Kh. 3243', Viola 3440', Simp 3485',
 Arb. 3554'
 TD 3570'
 5" @ 3570'
 CO
 6/3439-40
 FU 250' oil, 1000' wtr., SP
 12/3006-12, 18/2997-3003, 10/2952-57,
 500,000 cfg, 40 to 50 bwpd
 PB 3003'
 PB 2965', 2500A wtr.
 D&A

FABEN GILSTRAP

County McPherson State Kansas
 Sec. 33 (Blk.) 20 (Sur.) 1W Map No.
 Operator Virginia Drlg.
 Well No. 1 Farm Price
 Elev. 1523 Location SW SWNW

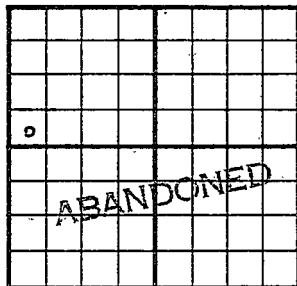

330 Ft. From S Line NW
330 Ft. From W Line Quarter
 1st. Report
 Completion JAN 1 9 1955
 Remarks Wildcat
Co. tools
 Spudding Date 10-21-54

Drlg. Data D & A TD 3570
8" @ 155 M; ss. 2943 DST 2955-68
open 1 hr. gas in 30 min. Rec. 10' mud
1015# DST 2968-92 open 1 hr. Rec. 20'
mud 0# DST 2997-3022 open 1 hr.
gas in 8 min. 1,000,000 cfg 90' mud
60' mw 915# Kh. 3243 Viola 3440
Simp. 3485 Arb. 3554 TD 3570
5" @ 3570 CO 6/ 3439-40 FU 250' oil
1000' wtr. SP 12/ 3006-12 18/ 2997-
3003 10/ 2952-57 500,000 cfg. 40 to 50
bwpd PB 3003 PB 2965 2500 A wtr
D & A

FABEN GILSTRAP