

Map No. KANSAS Sec. 33 Twp. 20 R. 3^w

Well No. 91 - E. Stuckey Farm
Nypay Oil Company


_____ Ft. from N. Line

330 Ft. from S. Line

_____ Ft. from E. Line

990 Ft. from W. Line

1930

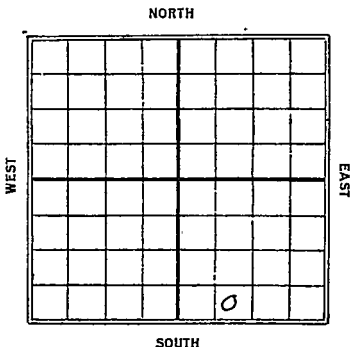

Date	REPORT
4/16	Pay
4/23	Wilcox 480'
4/30	" 2310'
5/7	" 2625'
5/14	" 3028'
5/21	" 3240 Top
	Viola 3236'
5/28	Wilcox 3265-95'
	Swab 470 bbl oil
	7 hrs.
6/4	Wilcox 3265-95'
	T.D. 3295'
	Swab 1505 bbl
	Comp.
1931	OWDID
5/27	Old T.D. 3295'
	Wilcox 3327-37 no increase
	Top Silice lime 3337
	Pay 3337-40
	T.D. 3357
	swab 365 bbl 12 hrs
	(over)

6/3- Pay 3337-40'
Sulc lime 3337-57
T.D. 3357
1250 bbl oil
Comp.

Form 28-121 Rev. 9-28
H. H. Hutton

Map No. **KANSAS** Sec. *33* Twp. *20* R. *2 W*

43
Well No. *1 E. Stuckey*

G. J. O'Connell Company
Contractor

SECTION PLAT

..... Ft. from N. Line

380 Ft. from S. Line

..... Ft. from E. Line

990 Ft. from W. Line

FIRST REPORTS

Location.....

Rig up.....

Drilling and Remarks:

*Rig
Hoisting*

RECORD

Cased..... in., ft.

Sand.....

Gas.....

Oil.....

Total Depth.....

PRODUCTION

1st 24 hrs. Nat.....

1st 24 hrs. after shot.....

Gas..... Cu. Ft.

Dry Hole.....

Abandoned.....

Date

APR 16 1930 *192*

S. J. LEWIS Scout

Map No. **KANSAS** Sec. **33** Twp. **20** R. **2 W**

43
Well No. **1 E. Structure**

Gary Oil Company

Contractor

SECTION PLAT

..... Ft. from N. Line

330 Ft. from S. Line

..... Ft. from E. Line

990 Ft. from W. Line

COMPLETED

Location.....

Rig up.....

Drilling and Remarks:

Well 02265-95

*swath
150586*

RECORD

Cased..... in., ft.

Sand.....

Gas.....

Oil.....

Total Depth **3295**

PRODUCTION

1st 24 hrs. Nat.....

1st 24 hrs. after shot.....

Gas..... Cu. Ft.

Dry Hole.....

Abandoned.....

Date

JUN 4 1930

S. J. LEWIS

Scout

McPherson

43 KANSAS

Map No. _____ Sec. *33* Twp. *20* R. *3* ^W

Well No. *1 E. Stucky*

Gypsum Oil Co Company

Contractor

FIRST REPORTS

SECTION PLAT

_____ Ft. from N. Line

330 Ft. from S. Line

_____ Ft. from E. Line

990 Ft. from W. Line

" *Old well deeper*"

RECORD

Location _____

JD was 3795'
Rig up _____

Drilling and Remarks:

Wilcox 3377-37' no increase

Top Hill 3337'

Pay 3337-40

aba 365 Bls

17 hours.

Cased _____ in., _____ ft.

Sand _____

Gas _____

Oil _____

Total Depth *3357'*

PRODUCTION

1st 24 hrs. Nat. _____

1st 24 hrs. after shot _____

Gas _____ Cu. Ft.

Dry Hole _____

Abandoned _____

Date

MAY 27 1931

CHAS. L. SHERWOOD

192

Scout

