FORM 51 10M 7-48 PETROL

KANSAS


Rice

Section 34 Township 20 Range 7W

Well No. 1 Engelland

Company Skelly

Wildcat

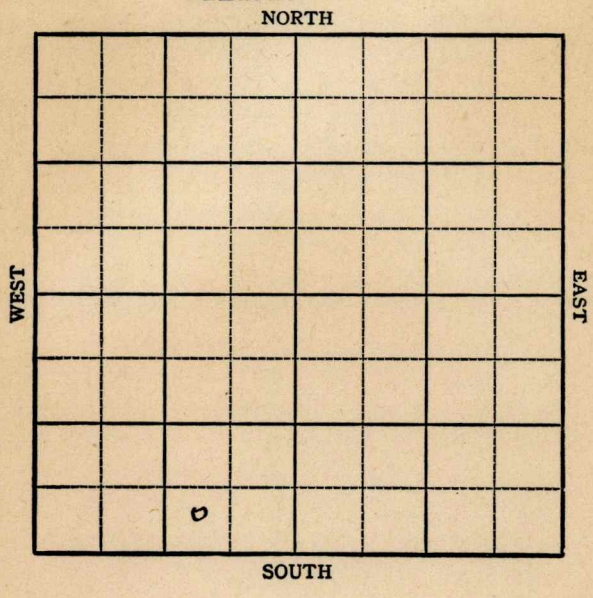

FORM 252-A
5M 10-48 PETROL


KANSAS Rice

Sec. 34 Twp. 20 R. 7W

Well No. 1 Engelland Farm

Skelly Company

Wildcat

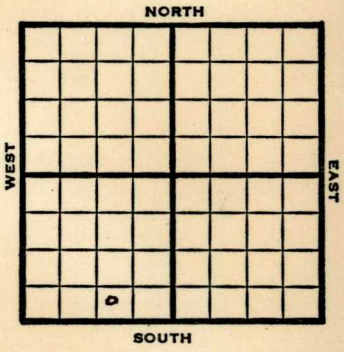

_____ Ft. from N. Line

450 Ft. from S. Line

940 Ft. from E. Line

_____ Ft. from W. Line

SW SE SW

1948	Elev. 1623' REPORT
11/17	Drlg 250'
	8" @ 213'
11/23	Drlg 1620'
11/30	Lansing 2896'
	Cong 3337-53'
	TD 3353'
	5"@ 3348'
	880' oil & 180' wtr.
12/6	"
12/14	Swb 18 bbls oil & 64 W - 5 hrs.
12/22	"
12/29	"
1/5	#
1/12	"
1/19	"
1/26	Cong 3337'
	5" @ 3348'
	500 acid
	Pump 50 oil & 116W Pot.
	Gr. 40°
	TD 3362'
	COMPLETED

Form 26 200 Bks. 9-48 Petrol

Kansas

Wildcat

Map No. _____ Sec. 34 Twp. 20 R. 7W


Well No. 1 Engelland

Skelly Company

FIRST REPORT Contractor

SW SE SW

SECTION PLAT

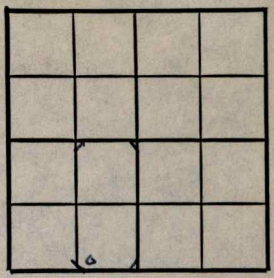

_____ Ft. from N. Line

450 Ft. from S. Line

940 Ft. from E. Line

_____ Ft. from W. Line

Rice County

Location _____

Rig up _____

Drilling and Remarks:

drlg. 250

8" @ 213

RECORD

Cased _____ in., _____ ft.

Sand _____

Gas _____

Oil _____

Total Depth _____

PRODUCTION

1st 24 hrs. Nat. _____

1st 24 hrs. after shot _____

Gas _____ Cu. Ft.

Dry Hole _____

Abandoned _____

Date

NOV 17 1948 19 S. J. LEWIS Scout

Form 26 200 Bks. 9-48 Petrol

Kansas

Wildcat

Map No. 49 Sec. 34 Twp. 20 R. 7W

Well No. 1 Engelland

Skelly Company


COMPLETE

Contractor

SW SE SW

E. 1623

SECTION PLAT

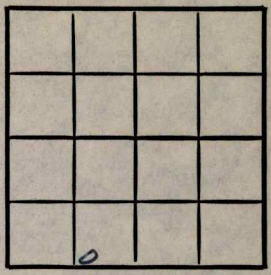

____ Ft. from N. Line

450 Ft. from S. Line

940 Ft. from E. Line

____ Ft. from W. Line

Rice County

Location

Rig up

Drilling and Remarks:

Comp 8-29-49
8" @ 3348'.
500 acid
Pump 50 bbl + 116 BW
P & A.

40 - 4e

RECORD

Cased ____ in., ____ ft.

Sand

Gas

Oil

Total Depth 3362

PRODUCTION

1st 24 hrs. Nat.

1st 24 hrs. after shot

Gas ____ Cu. Ft.

Dry Hole

Abandoned

Date

JAN 26 1949 19

S. J. LEWIS Scout