
McPherson

FORM 51-SM-6-29-PETROL

Map No. KANSAS Sec. 34 Twp. 20 R. 3 W

Well No. 1 - Kinney Farm

Gypsy Oil Company

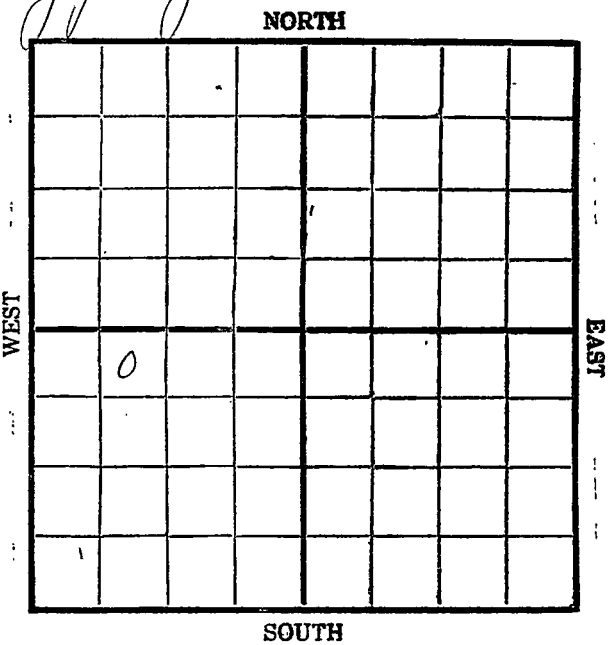

Location

Drilling Remarks

Rig Up

Drilling Remarks

RECORD

Cased ____ in. ____ ft.

Sand

Gas

Oil

Total Depth

PRODUCTION

1st 24 hrs. Nat.

1st 24 hrs. after shot

Gas ____ cu. ft.

Dry Hole

Abandoned


FORM 252A-5M-12-28-PETROL

Nl Pherson

Map No. KANSAS Sec. 34 Twp. 20 R. 3 W

Well No. 1 - Kinsey Farm

Gypsy Oil Company

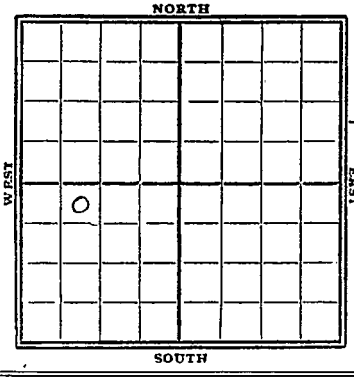

330 Ft. from N. Line

Ft. from S. Line

Ft. from E. Line

940 Ft. from W. Line

1929

Date	REPORT
11/13	Bldg Rig (rotary)
11/20	—
11/27	177' S.P.
12/4	Ldg 1650'
12/11	" 2490
12/18	Top Chat 3067
	Sm 8" - 3072' T.D.
12/23	Cut 3072'
12/30	Chat 3067-78'
	T.D. 3102'
	1 3/4 M gas
	5 bbl oil per day
	Corbs.

Form 26c—1M Blks—9-28

Mr Nelson

Map No. KANSAS Sec. 24 Twp. 28 R. 8 W

43

Well No. J. Kinney

Gypsy Oil Company

Contractor


SECTION PLAT

330 Ft. from N. Line

Ft. from S. Line

Ft. from E. Line

990 Ft. from W. Line

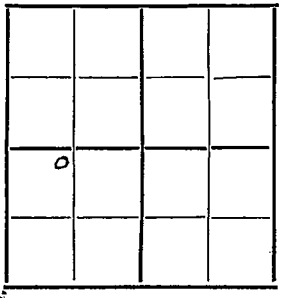

FIRST REPORTS

Location

Rig up

Drilling and Remarks:

Building rig

Rotary

RECORD

Cased in., ft.

Sand

Gas

Oil

Total Depth

PRODUCTION

1st 24 hrs. Nat.

1st 24 hrs. after shot

Gas Cu. Ft.

Dry Hole

Abandoned

Date

NOV 13 1929

192

S. J. LEWIS Scout

Form 28—1M Hks.—9-28

M-Pherson

Map No. KANSAS Sec. 34 Twp. 20 R. 2W


43

Well No. 1 Kinney

Gypsy Oil Co. Company

Contractor

SECTION PLAT

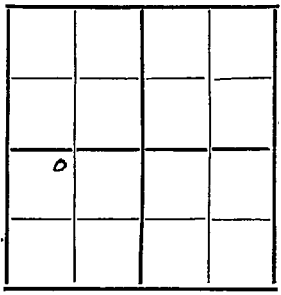

330 Ft. from N. Line

Ft. from S. Line

Ft. from E. Line

990 Ft. from W. Line

COMPLETED

Location

Rig up

Drilling and Remarks:

Chat 2067-78

1 3/4 MCF Gas

5 BBL oil a day

RECORD

Cased in., ft.

Sand

Gas

Oil

Total Depth 2102

PRODUCTION

1st 24 hrs. Nat.

1st 24 hrs. after shot

Gas Cu. Ft.

Dry Hole

Abandoned

Date

DEC 30 1929 192

S. J. LEWIS Scout