
McPherson

Form 51—5M—2-29—34703

Map No. KANSAS Sec. 34 Twp. 20 R. 3W

Well No. 2 Kinney Farm

Gypsy Oil Company

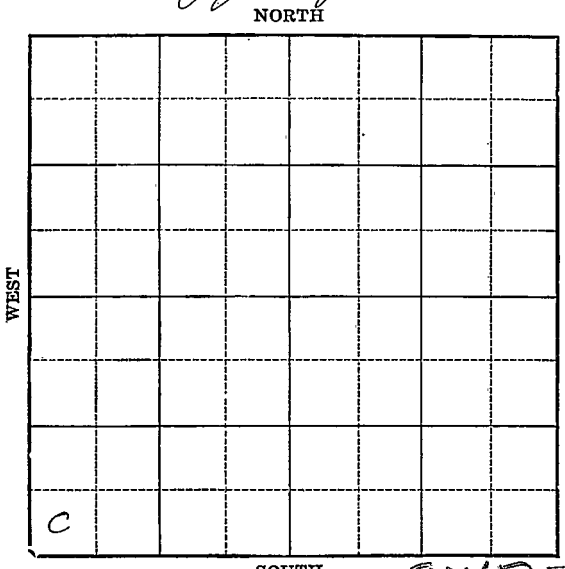

OWDD

Location

Drilling Remarks

Rig Up

Drilling Remarks

RECORD

Cased ____ in. ____ ft.

Sand

Gas

Oil

Total Depth

PRODUCTION

1st 24 hrs. Nat.

1st 24 hrs. after shot

Gas ____ cu. ft.

Dry Hole

Abandoned


Mc Pherson

Form 252A—5M—11-29—38055

Map No. KANSAS Sec. 34 Twp. 20 R. 3w

Well No. 2 J. Kinney Farm

Gypsy Oil Company

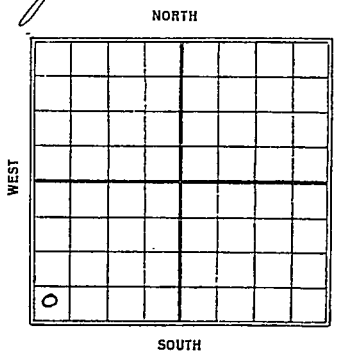

____ Ft. from N. Line

330 Ft. from S. Line

____ Ft. from E. Line

330 Ft. from W. Line

1030

Date	REPORT
5/14	Rotary Rig
5/21	Rdy. rig
5/28	Rdy. 1776.5'
6/4	Top Chat 2992, Sure Miss Lime 3060' - Rdy 3080'
6/11	Top Viola 3340' T.D. 3346' cement 8"
6/18	Vulcan 3356-72' TD 3372 Swab 790 bbl oil
	Comp.
1937	OWDD
11/30	Old TD 3372 Viola Lime 3427-34 TD 3434 Hole full oil 5 hr Well pumps.
	(over)

12/7. Clare 3427-34
TD 3434
pump 695 bbl oil and
60 bbl water 24 hrs
Comp.

Form 26 - 1M B15 - 9-28

M Pearson

Map No. KANSAS Sec. 34 Twp. 20 R. 3W


43

Well No. 2 Kinney


Contractor

SECTION PLAT

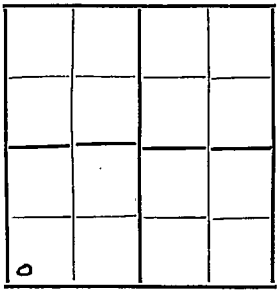

.....Ft. from N. Line

330 Ft. from S. Line

.....Ft. from E. Line

330 Ft. from W. Line

FIRST REPORTS

Location.....

Rig up.....

Drilling and Remarks:

Rotary

RCS

RECORD

Cased.....in., ...ft.

Sand.....

Gas.....

Oil.....

Total Depth.....

PRODUCTION

1st 24 hrs. Nat.....

1st 24 hrs. after shot.....

Gas.....Cu. Ft.

Dry Hole.....

Abandoned.....

Date

MAY 14 1930

.....192.....

S. J. LEWIS Scout

Form 26—1M Bks.—9-26






Gypsy Oil Company

Contractor

SECTION PLAT

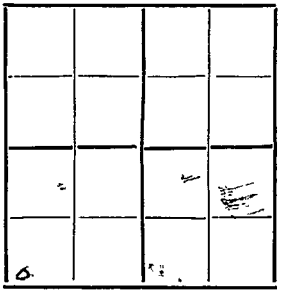

.....Ft. from N. Line

330 Ft. from S. Line

.....Ft. from E. Line

330 Ft. from W. Line

COMPLETED

Location.....

Rig up.....

Drilling and Remarks:

Wilcox 3356-72

Simpson 3708-18

RECORD

Cased.....in., ...ft.

Sand.....

Gas.....

Oil.....

Total Depth 3372

PRODUCTION

1st 24 hrs. Nat.....

1st 24 hrs. after shot.....

Gas.....Cu. Ft.

Dry Hole.....

Abandoned.....

Date

JUN 18 1930

S. J. LEWIS Scout

Form 26—1M Bks.—9-28 McPherson

43 KANSAS

Map No. ..... Sec. 34 Twp. 20 R. 3 W

Well No. 2 Kinney

Gypsy Oil Co ..... Company

..... Contractor

FIRST REPORTS


..... Ft. from N. Line

330 Ft. from S. Line

..... Ft. from E. Line

330 Ft. from W. Line

SECTION PLAT

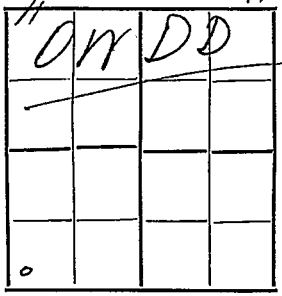

Location .....

Rig up .....

Drilling and Remarks:

Top Siliceous 3427-3434

HFO in 5 hours.

Will Pump

RECORD

Cased ..... in. ..... ft.

Sand Wilcox 3356-72

Gas .....

Oil .....

Total Depth 3372

PRODUCTION

1st 24 hrs. Nat. .....

1st 24 hrs. after shot .....

Gas ..... Cu. Ft.

Dry Hole .....

Abandoned .....

Date

NOV 30 1932 192

CHAS. L. SHERWOOD Scout

Form 26—1M Bks.—9-28

McPherson

43 KANSAS

Map No. ..... Sec. 34 Twp. 20 R. 3 W

Well No. 2 Kinney

Gypsy Oil Co Company

..... Contractor

COMPLETED


..... Ft. from N. Line

330 Ft. from S. Line

..... Ft. from E. Line

330 Ft. from W. Line

SECTION PLAT

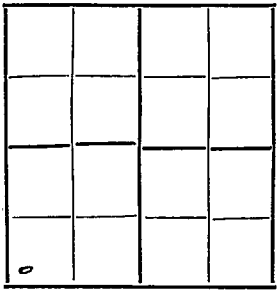

Location .....

Rig up .....

Drilling and Remarks:

Pump 695 Bbls Oil
60 Bbls Water
24 hours.

RECORD

Cased ..... in., ... ft.

Sand 3427 - 3434

Gas .....

Oil .....

Total Depth 3434

PRODUCTION

1st 24 hrs. Nat. .....

1st 24 hrs. after shot .....

Gas ..... Cu. Ft.

Dry Hole .....

Abandoned .....

Date

DEC 7 1932

CHAS. L. SHERWOOD

192 ..... Scout