


Section 34 Township 20 Range 6W

Well No. #1 Duvall (B)

Company Plains Exploration

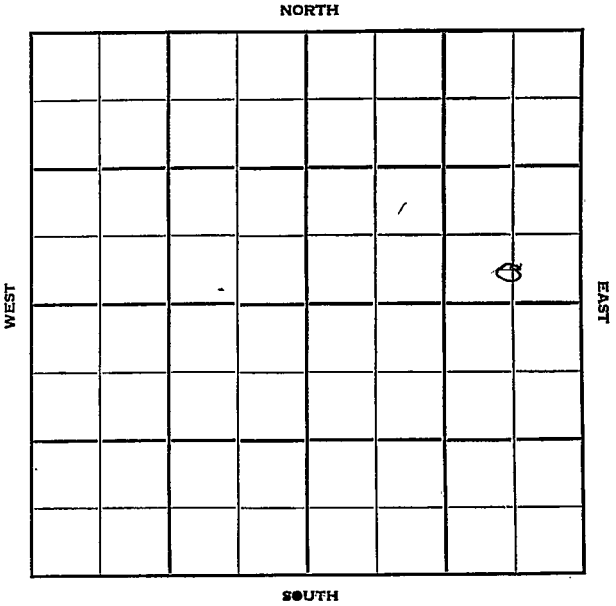

Rice

KANSAS

Sec. 34 Twp. 20 R. 6 W

Well No. # 1 Duvall (B) Farm

Plains Exploration Company

Sterling Contractor
Welsh


 Ft. from N. Line

330' Ft. from S. Line

660 Ft. from E. Line

 Ft. from W. Line

C S/2 SE NE

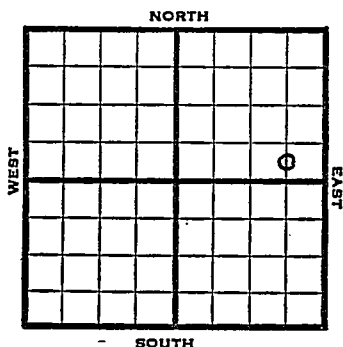

1952

Elev. 1591' REPORT

1/9

Location

2/6

TD 3403 5" @ 3403

2/13

S/10 BO & 10 BW 8 hrs. DD 3439'

TD 3444'

P/ 5 BO & 20 BWPD

2/20

Spud 1-10-52

Oil well TD 3444' 8" @ 145'

KC 2811' Cong. 3370' Miss 3386'

5" @ 3403 TD 3432' 4 GOPH 15 GWPH

S/10 BO 10 BW 8 hr. DD 3439'

DD 3444' P/5 BO 20 BWPD

Comp. 20 BOPD 30 BW


COMPLETED

County Rice State Kansas
 Sec. 34 (Blk.) 20 (Sur.) 6W Map No.

Operator Plains Exploration

Well No. 1 Farm Duval (B)

Elev. Location C S/2 SE NE

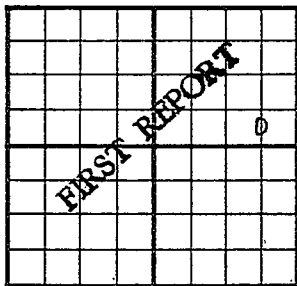

330 Ft. From S Line NE

660 Ft. From E Line Quarter

1st. Report JAN 9 1952

Completion

Remarks


Sterling - Contr.

Spudding Date

Drilg. Data Welsh

Location

J. E. TYRA

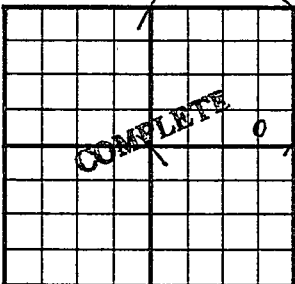County	Rice	State	Kansas
Sec.	34 (Blk. Twp.)	20 (Sur. Rge.)	6 W Map No.
Operator	Plains Exploration		
Well No.	1	Farm	Duvall "B"
Elev.	1591	Location	C S L SE NE
		330 Ft. From S	Line NE
		660 Ft. From E	Line Quarter
		1st. Report	
		Completion FEB 20 1952	
		Remarks Welsh Pool	
		Sterling Drlg. - Contr.	
		Spudding Date 1-10-52	

Drlg. Data Oil well TD 3444
 8" @ 145 KC 2811 Cong. 3370
 Miss. 3386 5" @ 3403 TD 3432
 4 goph 15 gwph S/ 10 bo 10 bw. 8 hr.
 DD 3439 DD 3444 P/ 5 bo 20 bwpd
 Comp. 20 bopd 30 bw

J. G. McGEHEE