


Section 34 Township 20 Range 6-WWell No. #1 DuvalCompany Eldorado Ref etal

NORTH

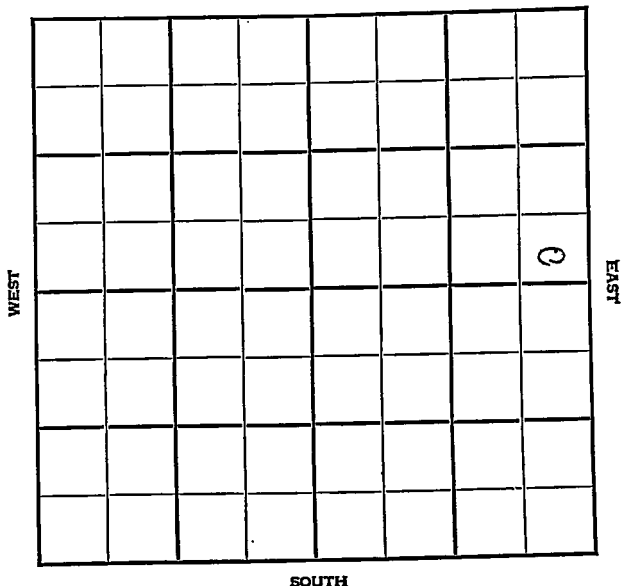

SOUTH

KANSAS

Rice

Sec. 34 Twp. 20 R. 6W

Well No. #1 Duval Farm

Eldorado Ref. et al Company

Welch Pool


       Ft. from N. Line

330' Ft. from S. Line

330' Ft. from E. Line

       Ft. from W. Line

SE NE

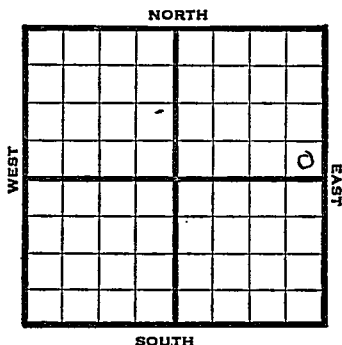

1948 Elev. 1599' REPORT

7/21 RUR

7/28 8" @ 175'  
D<sub>1</sub>lg 2890'

8/4 Mississippi 3372-78'  
TD 3378'  
5" @ 3372'

8/11 M<sub>1</sub>ss 3372'  
5" @ 3372'  
TD 3473'

ABANDONED

Map No. \_\_\_\_\_ Sec. 34 Twp. 20 R. 6W

Well No. 1 Duval

Eldorado Ref etal. Company

**FIRST REPORT**

Contractor

SE NE


SECTION PLAT

\_\_\_\_\_ Ft. from N. Line

330 Ft. from S. Line

330 Ft. from E. Line

\_\_\_\_\_ Ft. from W. Line

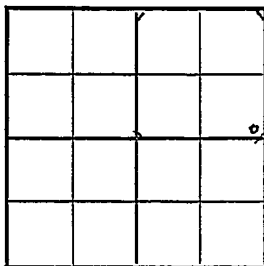

Rice County

Location \_\_\_\_\_

Rig up \_\_\_\_\_

Drilling and Remarks:  
RUR

RECORD

Cased \_\_\_\_\_ in., \_\_\_\_\_ ft.

Sand \_\_\_\_\_

Gas \_\_\_\_\_

Oil \_\_\_\_\_

Total Depth \_\_\_\_\_

PRODUCTION

1st 24 hrs. Nat. \_\_\_\_\_

1st 24 hrs. after shot \_\_\_\_\_

Gas \_\_\_\_\_ Cu. Ft.

Dry Hole \_\_\_\_\_

Abandoned \_\_\_\_\_

Date

JUL 21 1948 19 S. J. LEWIS Scout

Rice County Kansas State

Map No. 48 Sec. 34 Twp. 20 R. 6W

Well No. 1 Duval

Eldorado Ref. etal. Company

ABANDONED Contractor

SE NE

*E11599*

SECTION PLAT

|  |  |  |  |  |  |  |   |
|--|--|--|--|--|--|--|---|
|  |  |  |  |  |  |  |   |
|  |  |  |  |  |  |  |   |
|  |  |  |  |  |  |  |   |
|  |  |  |  |  |  |  | 0 |
|  |  |  |  |  |  |  |   |
|  |  |  |  |  |  |  |   |
|  |  |  |  |  |  |  |   |
|  |  |  |  |  |  |  |   |

Ft. from N. Line

330 Ft. from S. Line

330 Ft. from E. Line

Ft. from W. Line

Welch Pool

Remarks:

*Mus 3372*

*3- "C3372*

*11/3+73*

Date  
AUG 11 1948

Scout  
S. J. LEWIS