

Rice

FORM 51


KANSAS

Section 34 Township 20 Range 6W

Well No. #5 Duvall

Company Plains Exploration

NORTH

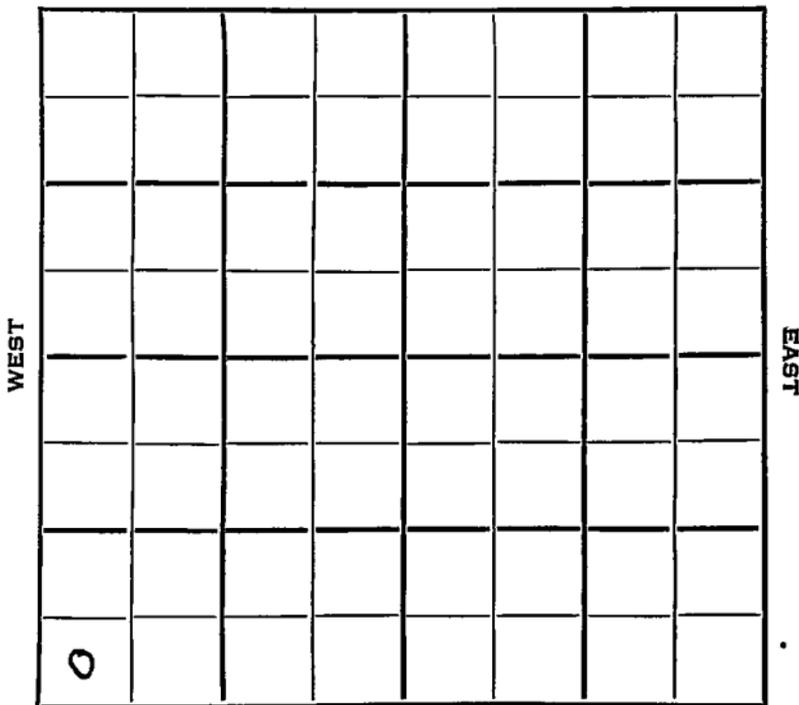

SOUTH

Rice KANSAS

SEC. 34 TWP. 20 R. 6W ✓

WELL NO.

5 Duvall FARM

Plains Exploration

CONTRACTOR

Sterling Drlg.


_____ Ft. from N. Line

330 _____ Ft. from S. Line

_____ Ft. from E. Line

330 _____ Ft. from W. Line

SW SW SW

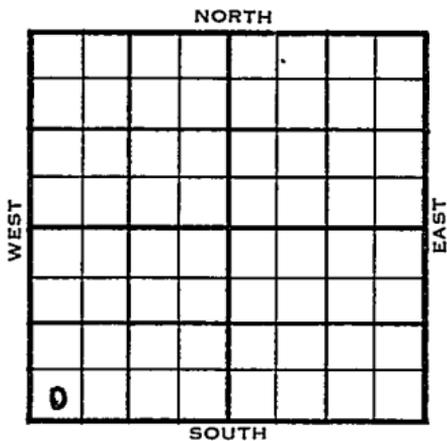

1953

ELEVATION
1601'

REPORT

12/16 MIR

1954
1/20

Spud 12-15-53
Oil Well
TD 3434'
8" @ 120'
Lans 2800', Miss 3388'
TD 3410'
5" @ 3410'
DD 3434
Hydro.
Comp. 25 bopd

COMPLETED

