


DX 78-1 Rice

KANSAS

Section 34 Township 20 Range 6W

Well No. #6 Duvall

Company Plains Exploration

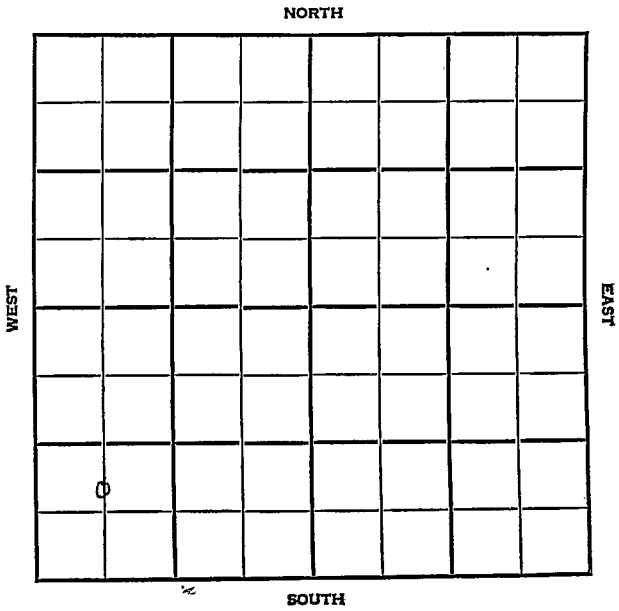

Rice

KANSAS

SEC.	TWP.	R.
34	20	6W

WELL NO.

#6 Duvall

FARM

COMPANY

Plains Exploration

CONTRACTOR

Sterling Drlg.

Welch-Bornholt Pool NORTH

Ft. from N. Line


990

Ft. from S. Line

Ft. from E. Line

660

Ft. from W. Line

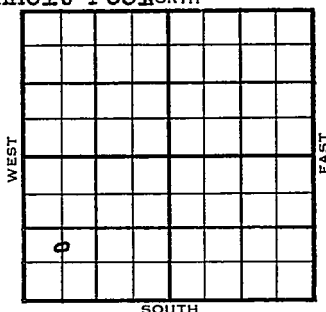C N $\frac{1}{2}$ SW SW

1954

ELEVATION

1596'

REPORT

11/11

Spud 11-5-54

8" @ 127'

Drlg. 1840'

12/22

Spud 11-5-54

Oil Well

TD 3441'

8" @ 127'

Lans 2810', Cong 3358' Miss 3391'

TD 3399'

5" @ 3399'

DD. 3441' 35 gf in hole. frac. S/ 60%

Wtr. S/ 13 boph 60% Wtr.

Comp 25 bopd. 60%

COMPLETED

County Rice State KansasSec. 34 (Blk. Twp.) 20 (Sur. Rge.) 6W Map No.Operator Plains ExplorationWell No. 6 Farm DuvallElev. Location C N $\frac{1}{2}$ SW SW

990 Ft. From S Line SW660 Ft. From W Line Quarter1st. Report NOV 10 1954

Completion

Remarks.

Sterling Drlg. - Contr.Spudding Date 11-5-54Drlg. Data Welch-Barnholt Pool8" @ 127 drlg. 1840


FABEN GILSTRAP

County Rice State Kansas
 Sec. 34 (Blk.) 20 (Sur.) 6W Map No.

Operator Plains Exploration

Well No. 6 Farm Duval "A"

Elev. 1596 Location C N $\frac{1}{2}$ SW SW

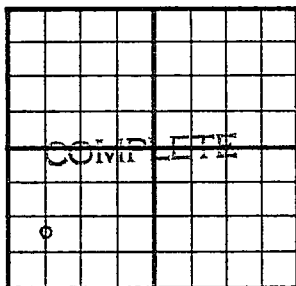

990 Ft. From S Line SW

660 Ft. From W Line Quarter

1st. Report

Completion DEC 22 1954

Remarks Welch-Bornholdt Pool
Sterling Drlg. - Contr.

Spudding Date 11-5-54

Drlg. Data Oil well TD 3441

8" @ 127 Lans. 2810 Cong. 3358

Miss. 3391 TD 3399 5" @ 3399

DD 3441 35 gf ih hole frac S/ 60% wtr.

S/ 13 boph 60% wtr. Comp. 25 bopd 60%

FABEN GILSTRAP