


Map No. Kansas Sec. 34 Twp. 20 R. 6 W

Well No. 1 Woods Farm

Prairie O. & G. Company

NORTH

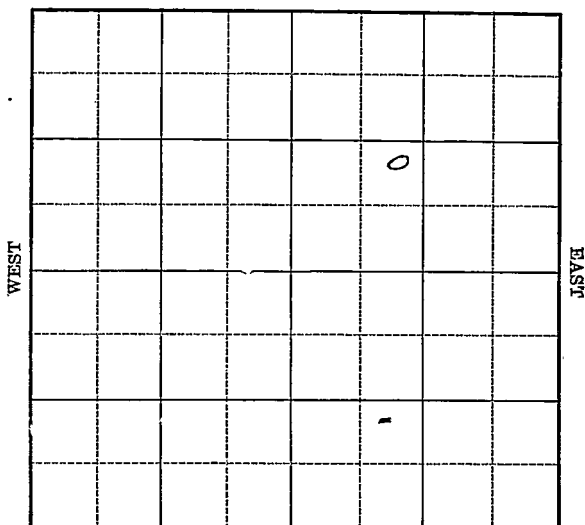

SOUTH

Location _____

Drilling Remarks

Rig Up _____

Drilling Remarks

RECORD

Cased _____ in. _____ ft.

Sand _____

Gas _____

Oil _____

Total Depth _____

PRODUCTION

1st 24 hrs. Nat. _____

1st 24 hrs. after shot _____

Gas _____ cu. ft.

Dry Hole _____


Abandoned _____

Prairie O. & G. Company

990 Ft. from S. Line

-----Ft. from E. Line

990 Ft. from W. Line

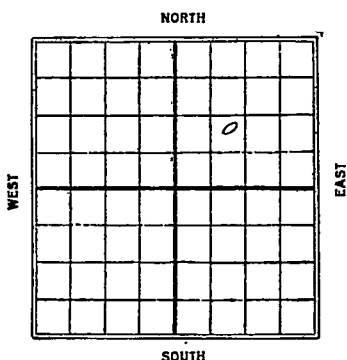

Date	REPORT
1925	
12/9	Location
1926	
4/14	Drilling 2860
4/21	" 2960
4/30	" 3100
5/5	" 3215
5/12	" 3833.
5/26	Top line 3265 B line 3460 T.D. 3465 will drill deeper.
6/2	Drly. 3475
6/9	" 3665'
6/16	run 5" 3665
6/23	" 3765'
6/30	T.D. 3765 fishing tool
7/14	U.R. 5' to 3805 T.D.
7/21	Drly. 3815'
7/28	Abandoned 3815'

Map No. *KANSAS* Sec. *34* Twp. *20* R. *6 N*

Well No. *1 Woods*

Prairie O & G Company

Contractor

SECTION PLAT

_____ Ft. from N. Line

990 Ft. from S. Line

_____ Ft. from E. Line

990 Ft. from W. Line

		o	

FIRST REPORTS

Location _____

Rig up _____

Drilling and Remarks:

Loc

RECORD

Cased _____ in., _____ ft.

Sand _____

Gas _____

Oil _____

Total Depth _____

PRODUCTION

1st 24 hrs. Nat. _____

1st 24 hrs. after shot _____

Gas _____ Cu. Ft.

Dry Hole _____

Abandoned _____

Date

DEC 9 1925

S. J. LEWIS Scout

MAP NO. KANSAS SEC. 34 TWP. 208 R. 6W

WELL NO. 1100

Prarie COMPANY

we show CONTRACTOR

SECTION PLAT

		0	

ABANDONED
_____ FT. FROM N. LINE

_____ FT. FROM S. LINE

_____ FT. FROM E. LINE

_____ FT. FROM W. LINE

LOCATION _____

RIG UP _____

DRILLING AND REMARKS:

Check Location
we show
3815 Sept
not changing

RECORD

CASED _____ IN. _____ FT.

SAND _____

GAS _____

OIL _____

TOTAL DEPTH 3810

PRODUCTION

1ST 24 HRS. NAT. _____

1ST 24 HRS. AFTER SHOT _____

GAS _____ CU. FT.

DRY HOLE ☒

ABANDONED ☒

DATE

7/20 192 6

SCOUT

Map No. *KANSAS* Sec. *24* Twp. *20* R. *6W*Well No. *1 Woods**Prairie Oil & Gas* Company

Contractor

SECTION PLAT

Ft. from N. Line

990 Ft. from S. Line

Ft. from E. Line

990 Ft. from W. Line**ABANDONED**

		o	

Location

Rig up

Drilling and Remarks:

*T 2815**D & A.*

RECORD

Cased _____ in., _____ ft.

Sand _____

Gas _____

Oil _____

Total Depth _____

PRODUCTION

1st 24 hrs. Nat. _____

1st 24 hrs. after shot _____

Gas _____ Cu. Ft.

Dry Hole _____

Abandoned _____

Date

JUL 28 1926

192

S. J. LEWIS

Scout