


Rice

Section 34 Township 20 Range 6W

Well No. #3 Libby

Company ~~Sterling Drilling~~ Plains Exploration

NORTH

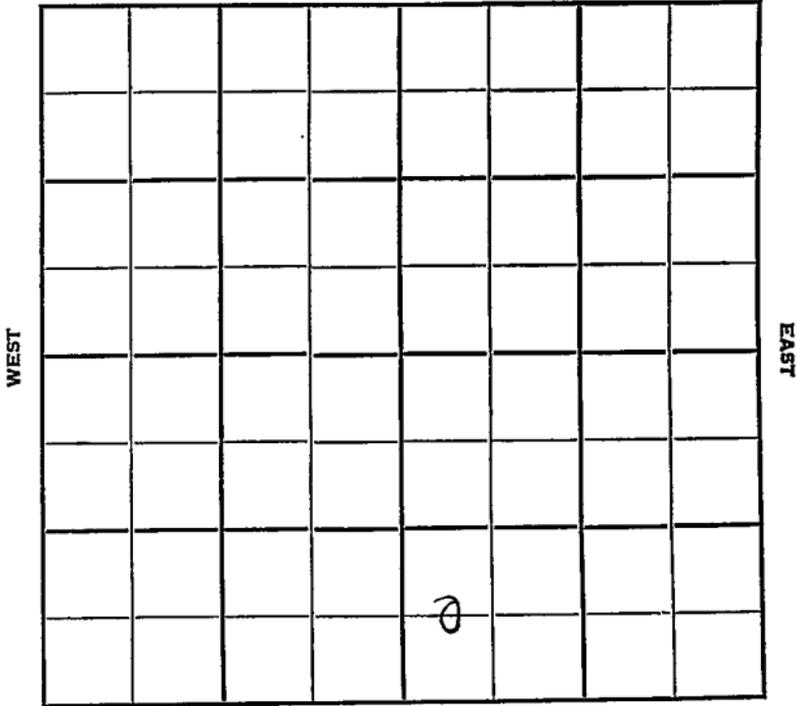

SOUTH

Rice

KANSAS

Sec. 34 Twp. 20 R. 6W ✓

Well No. #3 Libby Farm

Plains Exploration
Sterling Drlg. Company

Sterling Drlg. Contractor

Welsh


_____ Ft. from N. Line

660 Ft. from S. Line

330 Ft. from E. Line

_____ Ft. from W. Line

C W/2 SW SE

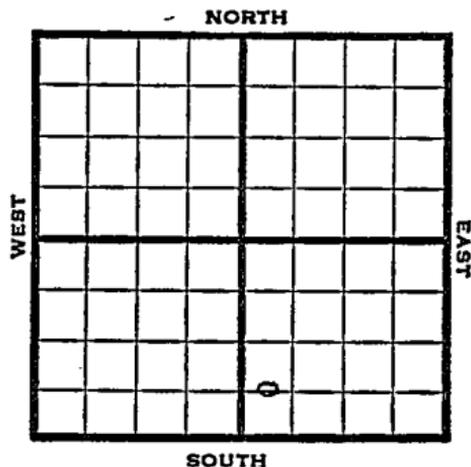

1951 Elev. 1585' REPORT

10/31 Spud 10-26-51
8" @ 152'
Drlg. 1975'

12/12 Spud 10-26-51
Oil Well TD 3426
8" @ 152
Lans. 2811 Cong. 3374
Miss 3391
5" @ 3405
TD 3426
Hydra S/8 bgph 20% wtr.
Comp. 30 bopd

COMPLETED

Map No. _____ Sec. 34 Twp. 20 R. 6W

Well No. 3 Libby

Plains Exploration Company

CORRECTION Contractor

C W L SW SE

SECTION PLAT

		o	

_____ Ft. from N. Line

660 Ft. from S. Line

_____ Ft. from E. Line

330 Ft. from W. Line

Rice County

Location _____

Rig up _____

Drilling and Remarks:

Reported
Sterling Drlg.

RECORD

Cased _____ in., _____ ft.

Sand _____

Gas _____

Oil _____

Total Depth _____

PRODUCTION

1st 24 hrs. Nat. _____

1st 24 hrs. after shot _____

Gas _____ Cu. Ft.

Dry Hole _____

Abandoned _____

Date

DEC 5 1951 19

J. E. TYRA

Scout

County Rice State Kansas

Sec. 34 (Blk. 20) (Sur. 6W) (Twp.) (Rge.) Map No.

Operator Plains Exploration

Well No. 3 Farm Libby

Elev. 1585 Location C W L SW SE

660 Ft. From S Line SE

330 Ft. From W Line Quarter

Ist. Report

DEC 1 2 1951

Completion

Remarks Welsh Pool

Sterling Drlg. - Contr.

Spudding Date 10-26-51

Drlg. Data Oil well TD 3426

8" @ 152 Lans. 2811 Cong. 3374

Miss. 3391 5" @ 3405 TD 3426

Hydro. S/ 8 bfpH 20% water

Comp. 30 bopd

J. E. TYRA