


Section 34 Township 20 Range 6W

Well No. 1 Moll

Company Sterling Drlg. & Plains Explor.

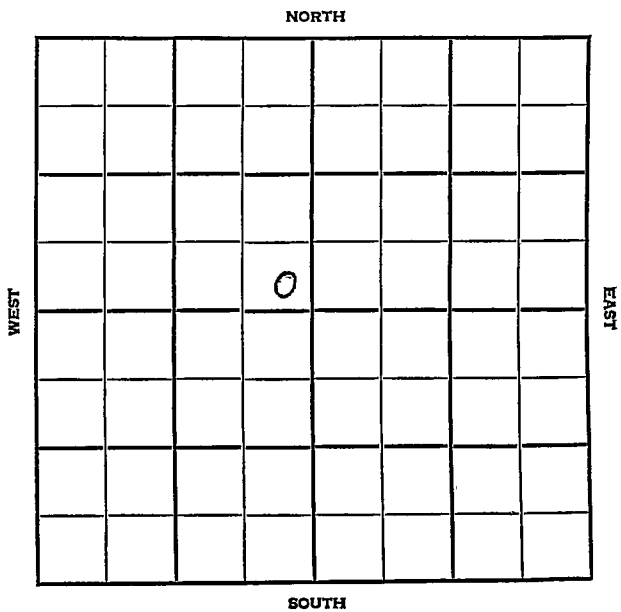

Rice

KANSAS

SEC.	TWP.	R.
34	20	6W

WELL NO.

I Moll

FARM

COMPANY

Sterling Drlg &amp; Plains Explor.

CONTRACTOR

Co. Tools

Welch-Bornholdt


\_\_\_\_\_ Ft. from N. Line

\_\_\_\_\_ Ft. from S. Line

\_\_\_\_\_ Ft. from E. Line

\_\_\_\_\_ Ft. from W. Line

SE SE NW

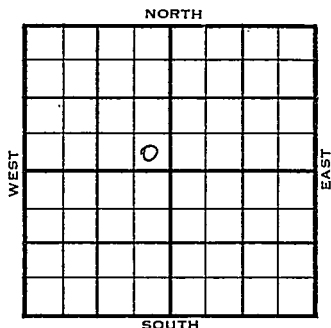

1955

ELEVATION  
1600'

REPORT

6/22 Comm 6-20-55  
Drlg 808-21 8 5/8" @ 120, 5 1/2" @ 3387 DD 3389,  
DD 3405, frac S/ 126 bf 8 hr., D & A  
B.L. 2800,1200,K.C. 2822,1222,C. 3344,  
1744, M. nos ch. 3382,1782,T.D. 3387**ABANDONED**

County Rice Elev. \_\_\_\_\_  
 Sec. 34 Twp. 20 Rge. 6W  
 Company Sterling Drlg. & Plains Explor.  
 Farm Name Moll No. 1

TOPS	DEPTH	LOG	DATUM
Anh.			
Tr.			
H.			
Tr.			
Dg.			
Bl.			
L.			
K.C.			
B.K.C.			
Ce.			
C.			
M.			
M.			
K.			
Mz.			
Me.			
V.			
S.			
S.			
A			
R.			
PE.			
G.			
TD.			

Loc. in Sec. SE SE NW  
 Geol. \_\_\_\_\_  
 Contr. Co. tools  
 Pool \_\_\_\_\_  
Welch-Bornholdt

JUN 22 '55  
 o  
 FIRST REPORT

Date Comm. 6-20-55  
drlg. 80

*KE12*

Co.  
 Lse.  
 No.  
 Sec.  
 T.  
 R.

County Rice Elev. 1600  
 Sec. 31 Twp. 20 Rge. 6W  
 Company Sterling Drlg. & Plains Explor.  
 FarmName Moll No. 1

TOPS	DEPTH	LOG	DATUM	Loc. in Sec.
Anh.				SE SE NW
Ip.				
H.				
Tr.				
Dg.				
Bl.	2800		1200	
L.				
K.C.	2822		1222	Geol.
B.K.C.				Contr.
Ce.				
C.	3344		1744	Co. tools
M. <i>is ch</i>	3382		1782	Pool
M.				Welch-Bornhold
K.				
Mz.				
Ma.				
V.				
S.				
S.				
A.				
R.				
PE.				
G.				
TD.	3387			

**ABANDONED**  
 AUG 24 1955

Date Comm. 6-20-55

8 5/8" @ 120 5 1/2" @ 3387 DD 3389

DD 3405 frac S/ 126 bf 8 hr.

D & A