
FORM 51 25M 8-50 WESTERN Rice KANSAS

Section 34 Township 20 Range 6W

Well No. #2 Duvall

Company Plains Exploration

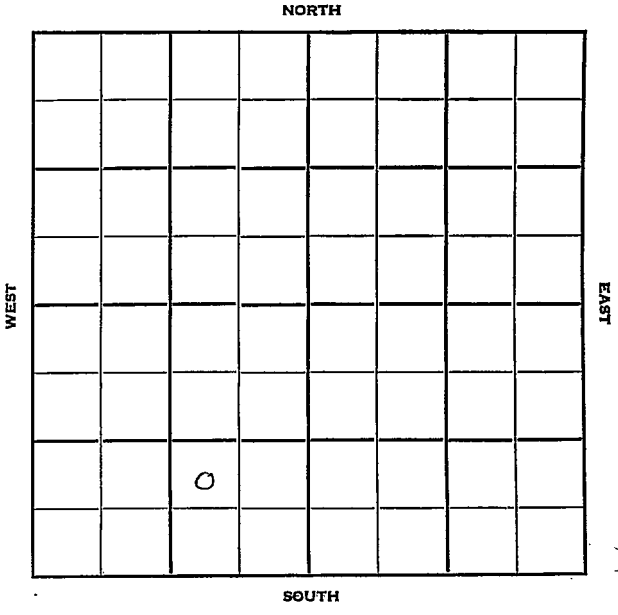

FORM 252-B
10M 10-50 PETROL

Rice

KANSAS

Sec. 34 Twp. 20 R. 6 W

Well No. # 2 Duvall Farm

Sterling Drlg
~~Plains Exploration~~ Company

Sterling Contractor


Ft. from N. Line

330
~~990~~ Ft. from S. Line

~~990~~ Ft. from E. Line

990 Ft. from W. Line

~~NW SE SW~~
SE SW SW

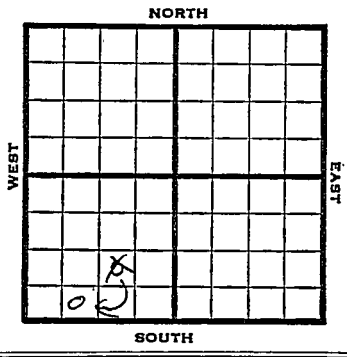

1951 Elev. 1599' REPORT

10/17 Spud 10-14-51
8" @ 125' WOC

11/7 Oil Well Spud 10-14-51
TD 3444 8" @ 125
Lans. 2821 Cong. 3361
Miss 3387 TD 3405
5" @ 3404 DD 3444
S/15 bopd Hydra S/50 bopd
Comp. 50 bopd

COMPLETED

FORM 275 FOR SALE BY KANSAS BLUE PRINT CO.


County Rice State Kansas

Sec. 34 (Blk. Twp.) 20 (Sur. Rge.) 6W Map No.

Operator Plains Exploration

Well No. 2 Farm Duvall

Elev. Location NW SE SW

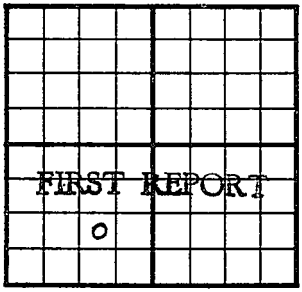

990 Ft. From S Line SW

990 Ft. From E Line Quarter

1st. Report OCT 17 1951

Completion

Remarks Sterling - Contr.

Spudding Date 10-14-51

Drlg. Data

8" @ 125 WOC

J. E. TYRA

Form 26 200 Bks. 8-50 Petrol

Kansas

Map No. _____ Sec. 34 Twp. 20 R. 6W


Well No. 2 Duvall

Sterling Drlg. Company

[redacted] Contractor

SE SW SW

SECTION PLAT

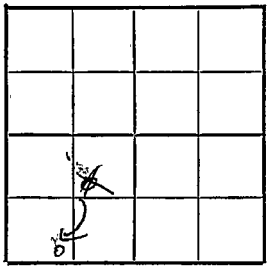

_____ Ft. from N. Line

330 Ft. from S. Line

_____ Ft. from E. Line

990 Ft. from W. Line

Rice County

Location _____

Rig up _____

Drilling and Remarks:

Comp. 11-7-51

NW SE SW

RECORD

Cased _____ in., _____ ft.

Sand _____

Gas _____

Oil _____

Total Depth _____

PRODUCTION

1st 24 hrs. Nat. _____

1st 24 hrs. after shot _____

Gas _____ Cu. Ft.

Dry Hole _____

Abandoned _____

Date

JAN 3 0 1952

19

J. G. McGEHEE Scout

FORM 275 FOR SALE BY KANSAS BLUE PRINT CO.


County Rice State Kansas

Sec. 34 (Blk. Twp.) 20 (Sur. Rge.) 6W Map No.

Operator Plains Exploration

Well No. 2 Farm Duvall

Elev. 1599 Location NW SE SW

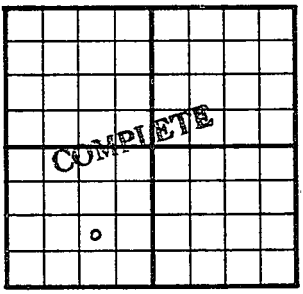

990 Ft. From S Line SW

990 Ft. From E Line Quarter

Ist. Report

Completion NOV 7 1951

Remarks

Sterling Drlg. - Contr.

Spudding Date 10-14-51

Drlg. Data Oil well TD 3444

8" @ 125 Lans. 2821 Cong. 3361

Miss. 3387 TD 3405 5" @ 3404 DD 3444

S/ 15 bopd Hydro. S/ 50 bopd

Comp. 50 bopd

J. E. TYRA