

KANSAS

Rice

Section 34 Township 20 Range 7W

Well No. 1 Engelland SWD


Company Skelly

Wherry

NORTH

WEST

EAST

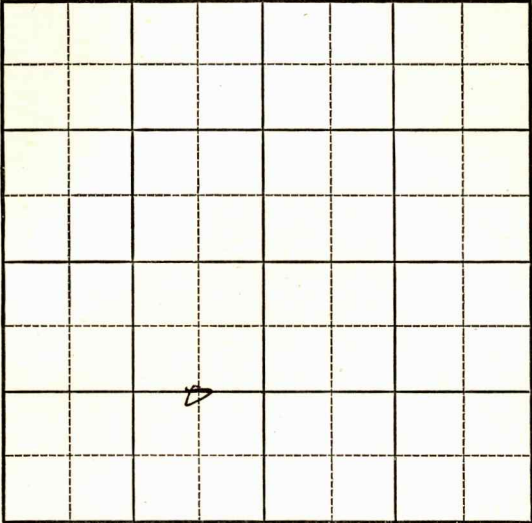

SOUTH

Rice

Sec. 34 Twp. 20 R. 7W 

Well No. #1 Engelland SWD Farm _____
Skelly Company _____
(Wherry Pool)


1320' Ft. from N. Line

_____ Ft. from S. Line

660' Ft. from E. Line

_____ Ft. from W. Line

C E $\frac{1}{2}$ SW

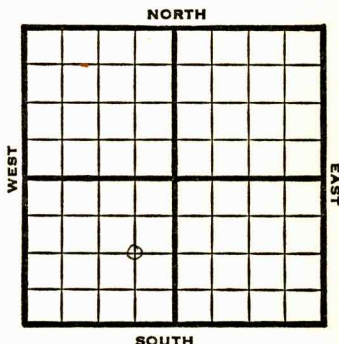

1949

Elev 1625'

REPORT

6/1

13" @ 20'

10" @ 50'

6/7

TD 625'

Run 7"

6/15

7"@ 625'

Fsg 1070'

6/21

Drlg 1159'

6/28

5"@ 1354'

Drlg 1357'

7/6

"

7/12

"

7/20

TD 1370'

1000 acid

7/27

"

8/3

"

8/10

TD 1370'

5"@ 1354'

SWD

Aband.

ABANDONED

Map No. _____ Sec. 34 Twp. 20 R. 7W

Well No. 1 Engelland SWD

Skelly Company

Contractor

C E $\frac{1}{2}$ SW


FIRST REPORT
SECTION PLAT

1320 Ft. from N. Line

_____ Ft. from S. Line

680 Ft. from E. Line

_____ Ft. from W. Line

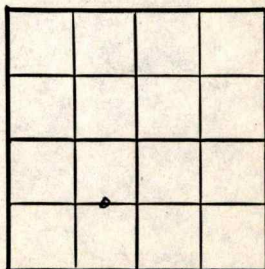

Rice County

Location _____

Rig up _____

Drilling and Remarks: _____

13" @ 20

10" @ 50

RECORD

Cased _____ in., _____ ft.

Sand _____

Gas _____

Oil _____

Total Depth _____

PRODUCTION

1st 24 hrs. Nat. _____

1st 24 hrs. after shot _____

Gas _____ Cu. Ft.

Dry Hole _____

Abandoned _____

Date

JUN 1 1949 19

S. J. LEWIS Scout

Kansas

Map No. K49 Sec. 34 Twp. 20 R. 7WWell No. 1 Engelland SWD

Skelly

Company

ABANDONED

Contractor

C E $\frac{1}{2}$ SW

E1.1625


SECTION PLAT

1320 Ft. from N. Line

Ft. from S. Line

680 Ft. from E. Line

Ft. from W. Line

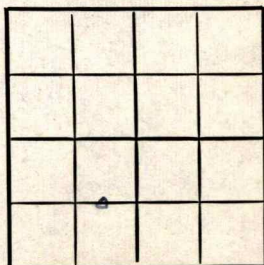

Rice County

RECORD

Location

Cased _____ in., _____ ft.

Rig up

Sand _____

Drilling and Remarks:

Gas _____

8" C1354

Oil _____

Total Depth 1320

SWD

PRODUCTION

1st 24 hrs. Nat. _____

1st 24 hrs. after shot _____

Gas _____ Cu. Ft.

Dry Hole _____

Abandoned _____

Date

AUG 10 1949 19

S. J. LEWIS Scout