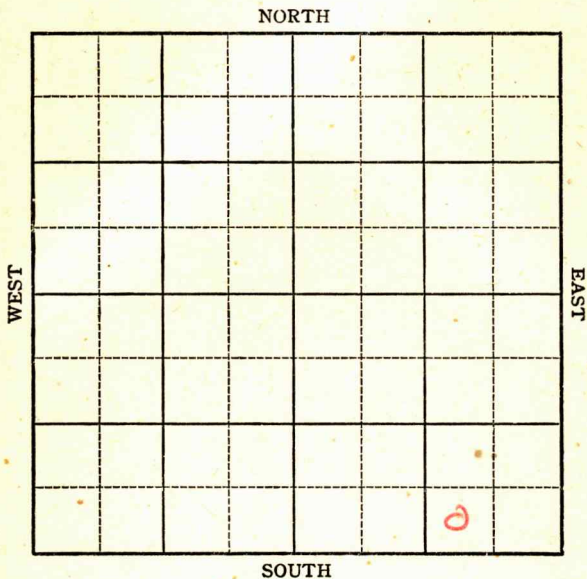


Section 35 Township 20 Range 7_aWWell No. 2 ChronisterCompany Tom Allen et al

Rice

Sec. 35 Twp. 20 R. 7-W ✓

Well No. # 2 Chronister Farm

Tom Allan et al. Company


Wherry Pool

 Ft. from N. Line

330 Ft. from S. Line

990 Ft. from E. Line

 Ft. from W. Line

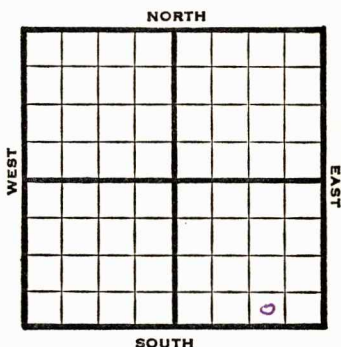

SW SE SE

REPORT

1947

6/18 Location

6/24 "

7/1 8" @ 157'
Drlg 1775'

7/8 Conglomerate 3409-12' TD
Run casing.

7/16 5" @ 3412'
Kinderhook 3470'
TD 3471'
SD

7/23 Miss. 3412'
T.D. 3471'
Abandoned

ABANDONED

Map No. 49 Sec. 35 Twp. 20 R. 7W

Well No. 2 Chronister


Tom Allan etal. Company

ABANDONED Contractor

SW SE SE

E 1.1628

SECTION PLAT

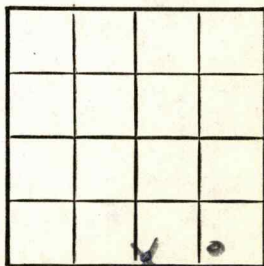

 Ft. from N. Line

330 Ft. from S. Line

990 Ft. from E. Line

 Ft. from W. Line

Rice County

Location

Rig up

Drilling and Remarks:

Miss 3412

RECORD

Cased in., ft.

Sand

Gas

Oil

Total Depth 3471

PRODUCTION

1st 24 hrs. Nat.

1st 24 hrs. after shot

Gas Cu. Ft.

Dry Hole

Abandoned

Date

JUL 23 1947 19 S. J. LEWIS Scout

Map No. _____ Sec. 35 Twp. 20 R. 7W

Well No. 2 Chronister

Tom Allan etal. Company

FIRST REPORT

Contractor

SW SE SE


SECTION PLAT

_____ Ft. from N. Line

330 Ft. from S. Line

990 Ft. from E. Line

_____ Ft. from W. Line

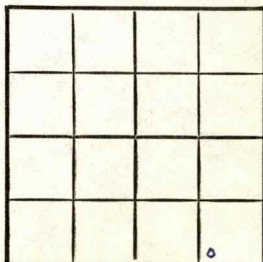

Rice County

Location X

Rig up _____

Drilling and Remarks:

RECORD

Cased _____ in., _____ ft.

Sand _____

Gas _____

Oil _____

Total Depth _____

PRODUCTION

1st 24 hrs. Nat. _____

1st 24 hrs. after shot _____

Gas _____ Cu. Ft.

Dry Hole _____

Abandoned _____

Date

JUN 1 8 1947

19

S. J. LEWIS Scout