


Section 35 Township 20 Range 6-W

Well No. #1 Harder

Company Don Ingling  
Welch Pool

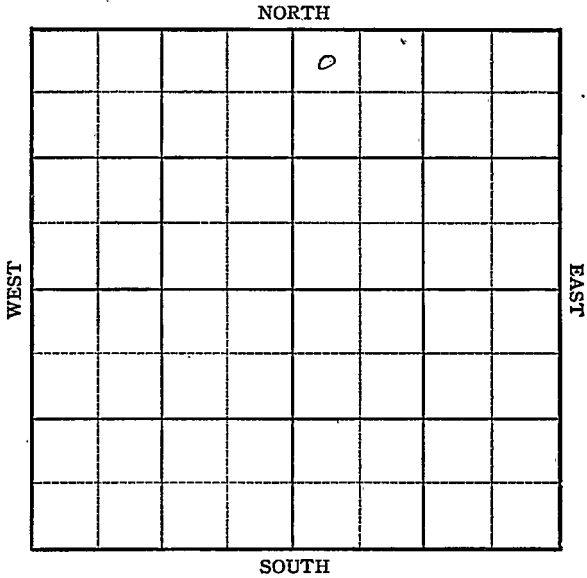

Sec. 35 Twp. 20 R. 6W

Well No. #1 Harder Farm

Don Ingling Company

Ingling Contractor  
Welch Pool


330' Ft. from N. Line

\_\_\_\_\_ Ft. from S. Line

\_\_\_\_\_ Ft. from E. Line

330' Ft. from W. Line

NW NE

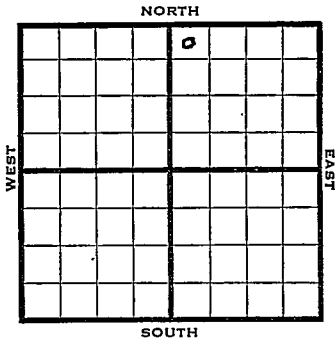

1949 Elev. 1578' REPORT

- 11/9 RUR
  - 11/16 8" @ 95'  
Drlg 1948'
  - 11/23 Drlg. 3160'
  - 11/29 Miss 3373-76'  
TD 3376'  
5" @ 3374'
  - 12/7 160' oil in 14 hrs.  
Drlg 3445'
  - 12/14 Miss 3373'  
TD 3448'
- ABANDONED**

Map No. \_\_\_\_\_ Sec. 35 Twp. 20 R. 6W

Well No. 1 Harder

Don Ingling Company

Ingling Contractor

NW NE

FIRST REPORT  
SECTION PLAT

		o	

330 Ft. from N. Line

\_\_\_\_\_ Ft. from S. Line

\_\_\_\_\_ Ft. from E. Line

330 Ft. from W. Line

Rice County

Location \_\_\_\_\_

Rig up \_\_\_\_\_

Drilling and Remarks:

R U R

## RECORD

Cased \_\_\_\_\_ in., \_\_\_\_\_ ft.

Sand \_\_\_\_\_

Gas \_\_\_\_\_

Oil \_\_\_\_\_

Total Depth \_\_\_\_\_

## PRODUCTION

1st 24 hrs. Nat. \_\_\_\_\_

1st 24 hrs. after shot \_\_\_\_\_

Gas \_\_\_\_\_ Cu. Ft.

Dry Hole \_\_\_\_\_

Abandoned \_\_\_\_\_

Date

NOV 9 1949 19

S. J. LEWIS

Scout

Map No. \_\_\_\_\_ Sec. 35 Twp. 20 R. 6W

Well No. 1 Harder

Don Ingling Company

**ABANDONED**

Contractor

NW NE

*E. 1578*  
SECTION PLAT

330 Ft. from N. Line

\_\_\_\_\_ Ft. from S. Line

\_\_\_\_\_ Ft. from E. Line

330 Ft. from W. Line

		15	

Rice County

Location \_\_\_\_\_

Rig up \_\_\_\_\_

Drilling and Remarks:

*Miss 3873*

**RECORD**

Cased \_\_\_\_\_ in., \_\_\_\_\_ ft.

Sand \_\_\_\_\_

Gas \_\_\_\_\_

Oil \_\_\_\_\_

Total Depth 344

**PRODUCTION**

1st 24 hrs. Nat. \_\_\_\_\_

1st 24 hrs. after shot \_\_\_\_\_

Gas \_\_\_\_\_ Cu. Ft.

Dry Hole \_\_\_\_\_

Abandoned \_\_\_\_\_

Date

DEC 14 1949

19

S. J. LEWIS

Scout