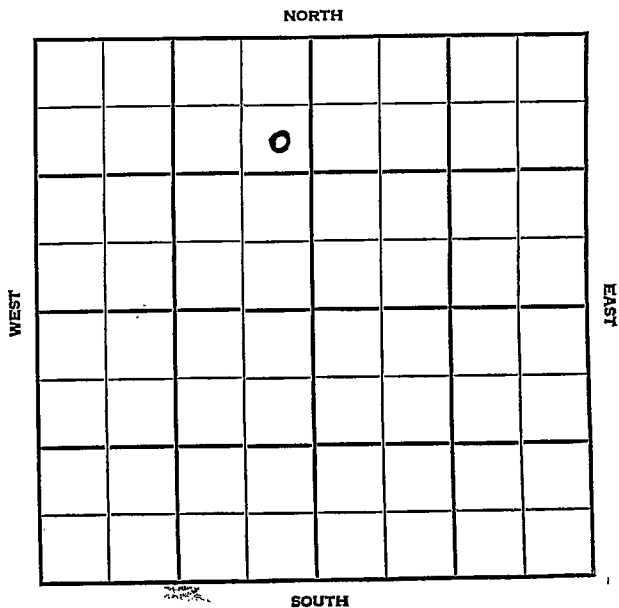


DX 78-1

Section 35 Township 20 Range 6WWell No. 3 Harder "A"Company Sterling Drlg. & Davis-Chölds

Rice KANSAS

SEC.	TWP.	R.
35	20	6W

WELL NO. FARM

3 Harder "A"

COMPANY

Sterling Drlg. & Davis-Childs

CONTRACTOR

Sterling


Welch-Bornholdt Pool

990 _____ Ft. from N. Line

_____ Ft. from S. Line

330 _____ Ft. from E. Line

_____ Ft. from W. Line

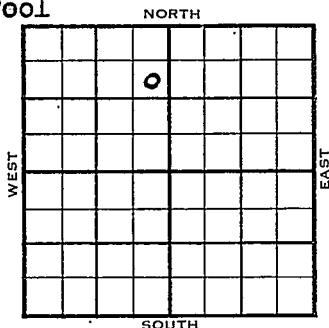

SE NE NW


	ELEVATION	REPORT
1954	1594'	

8/4 Spdg 8-3-54

9/1 Spud 8-3-54
 Oil Well
 TD 3393'
 8" @ 120'
 Lans 2812', Miss 3363',
 TD 3379'
 5" @ 3378'
 DD 3383'
 FU 210' oil 12 hr.
 DD 3393', FU 270' oil 5 gw 12 hr.
 frac. S/ 20 bo 10 bw.
 Comp 40 bopd. 20 bw.

COMPLETED

County Rice State Kansas
 Sec. 35 (Blk. 20 (Sur. 6W Map No.)
 (Twp.) (Rge.)
 Operator Sterling Drlg. & Davis-Childs
 Well No. 3 Farm Harder "A"
 Elev. 1594 Location SE NE NW

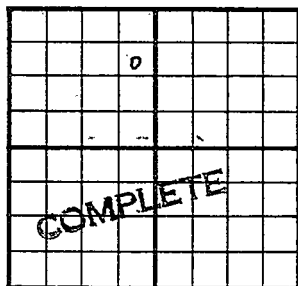

990Ft. From N Line NW
330Ft. From E Line Quarter
 1st. Report SEP 1 1954
 Completion SEP 1 1954
 Remarks Welch-Bornholdt Pool
Sterling - Contr.
 Spudding Date 8-3-54

Drlg. Data Oil well TD 3393

8" @ 120 Lans. 2812 Miss. 3363

TD 3379 5" @ 3378 DD 3383 FU 210' oil

12 hr. DD 3393 FU 270' oil 5 gw 12 hr.

frac S/ 20 bo 10 bw

Comp. 40 bopd 20 bw

FABEN GILSTRAP