


Map No. Rec 35 Sec. 20 Twp. 6^W

Well No. J Miller Farm
Prairie Company

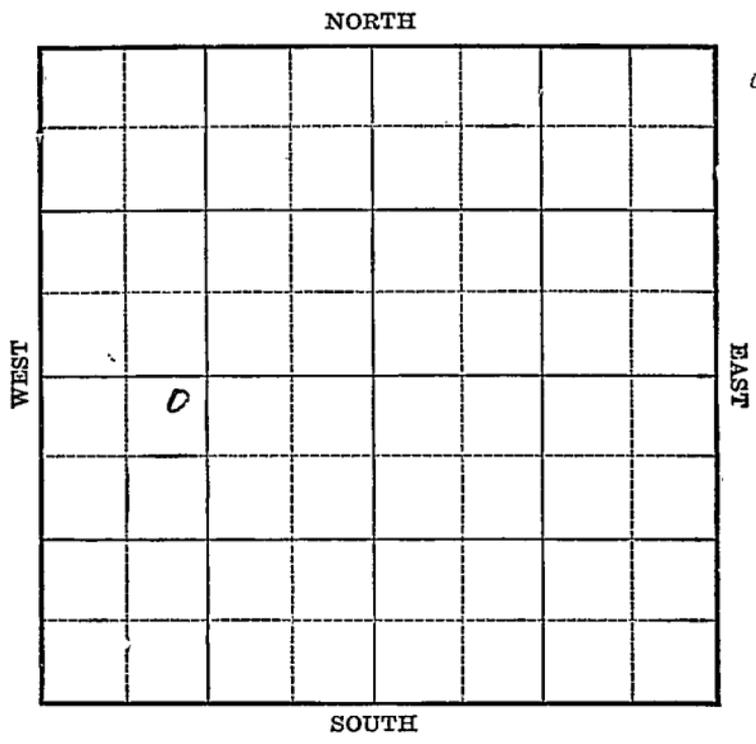

Location _____

Drilling Remarks:

Rig Up _____

Drilling Remarks:

RECORD

Cased _____ in. _____ ft.

Sand _____

Gas _____

Oil _____

Total Depth _____

PRODUCTION

1st 24 hrs. Nat. _____

1st 24 hrs. after shot _____

Gas _____ cu. ft.

Dry Hole _____

Abandoned _____

Map No. W. Map Plate Sec. 33 Twp. 20 R. 6W

Well No. W. GAS # Miller

P.O. & G Company

Contractor

FIRST REPORT

SECTION PLAT

200 Ft. from N. Line

_____ Ft. from S. Line

_____ Ft. from E. Line

1120 Ft. from W. Line

0			
0			

Location VV

Rig up _____

Drilling and Remarks:

RECORD

Cased _____ in., _____ ft.

Sand _____

Gas _____

Oil _____

Total Depth _____

PRODUCTION

1st 24 hrs. Nat. _____

1st 24 hrs. after shot _____

Gas _____ Cu. Ft.

Dry Hole _____

Abandoned _____

Date APR 21 1924

M. A. BENEAR

_____ 192_____ Scout

Map No. **KANSAS** Sec. **35** Twp. **20** R. **6 W**

Well No. **1-Miller**

Prairie O & G. Company

Contractor

COMPLETED

SECTION PLAT

200 Ft. from N. Line

_____ Ft. from S. Line

_____ Ft. from E. Line

1120 Ft. from W. Line

○			

Location _____

Rig up _____

Drilling and Remarks:

*Chat 3381-3413
100 yds per day*

RECORD

Cased _____ in., _____ ft.

Sand _____

Gas _____

Oil _____

Total Depth _____

PRODUCTION

1st 24 hrs. Nat. _____

1st 24 hrs. after shot _____

Gas _____ Cu. Ft.

Dry Hole _____

Abandoned _____

Date

NOV 23 1924

192_____

M. A. BENEAR

Scout

Rice
MAP No. KANSAS SEC. 35 TWP. 20S R. 6W
WELL No. 1 mile
Prairie COMPANY

CONTRACTOR

SECTION PLAT

0			

check with
our
ABANDONED

_____ FT. FROM N. LINE
_____ FT. FROM S. LINE
_____ FT. FROM E. LINE
_____ FT. FROM W. LINE

OK

LOCATION _____

RIG UP _____

DRILLING AND REMARKS:

dry hole
3395 - 3460
100 lbs

RECORD

CASED _____ IN., _____ FT.
SAND _____
GAS _____
OIL
TOTAL DEPTH 3460

PRODUCTION

1ST 24 HRS. NAT. _____
1ST 24 HRS. AFTER SHOT _____
GAS _____ CU. FT.
DRY HOLE _____
ABANDONED _____

DATE

7/18 1926

SCOUT