

Rice

Map No. Kans Sec. 35 Twp. 20 R. 6W


Well No. 2 Harder Farm
Phillips Pet Company

_____ Ft. from N. Line

990 Ft. from S. Line

990 Ft. from E. Line

_____ Ft. from W. Line

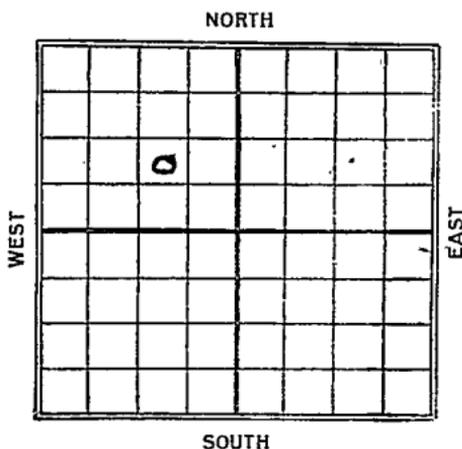

1926

Date

REPORT

Date	REPORT
9/22	Location
10/13	_____
10/20	Rig building
10/27	_____
11/3	Spud
11/10	Drlg 720
11/17	" 1375
11/24	" 1840
12/1	run 8" at 2294
12/8	Drlg 2530'
12/15	" 2735'
12/21	T.D. 2845 U.R.
12/29	same
1927	
1/5	T.D. 2950 U.R.
1/12	T.D. 3135 - U.R.
1/19	same
1/26	Drilling 3260
2/2	Top Chat 3370 - show oil 3387 - Run 5" @ 3390
2/9	T.D. 3473 swabbed 95 bbl. 16 hrs.
2/16	J. Chat 3370 oil 3387 J.D. 3473 90 bbls swab

Map No. no KANSAS Sec. 35 Twp. 20 R. 6W

Well No. 2 Hardee

Phillips Pet. Company

Contractor

SECTION PLAT

	0		

----- Ft. from N. Line

990 Ft. from S. Line

990 Ft. from E. Line

----- Ft. from W. Line

FIRST REPORTS

Location -----

Rig up -----

Drilling and Remarks:

Location

RECORD

Cased ----- in., ----- ft.

Sand -----

Gas -----

Oil -----

Total Depth -----

PRODUCTION

1st 24 hrs. Nat. -----

1st 24 hrs. after shot -----

Gas ----- Cu. Ft.

Dry Hole -----

Abandoned -----

Date

SEP 22 1920

S. J. LEWIS

Scout

MAP No. KANSAS SEC. 35 TWP. 20S R. 6W

WELL No. 2 Kordin

Phillips COMPANY

check with CONTRACTOR

SECTION PLAT

FT. FROM N. ~~DISCONTINUED~~

FT. FROM S. LINE

FT. FROM E. LINE

FT. FROM W. LINE

O.K.

LOCATION _____

RIG UP _____

DRILLING AND REMARKS:

3370 } chat
3473 }
100 bbls
33

RECORD

CASED _____ IN. _____ FT.

SAND _____

GAS _____

OIL _____

TOTAL DEPTH 3473

PRODUCTION

1ST 24 HRS. NAT. _____

1ST 24 HRS. AFTER SHOT _____

GAS _____ CU. FT.

DRY HOLE _____

ABANDONED _____

DATE

2/9

1927

SCOUT

Map No. *no map* **KANSAS** Sec. *35* Twp. *20* R. *6 W*

Well No. *2 Harder*

Phillips P & C Company

Contractor

SECTION PLAT

	0		

_____ Ft. from N. Line

990 Ft. from S. Line

990 Ft. from E. Line

_____ Ft. from W. Line

COMPLETED

Location _____

Rig up _____

Drilling and Remarks:

Y Cha 8. 3370

Oil 3387

Y 3473

90 ft. Harder

RECORD

Cased _____ in., _____ ft.

Sand _____

Gas _____

Oil _____

Total Depth _____

PRODUCTION

1st 24 hrs. Nat. _____

1st 24 hrs. after shot _____

Gas _____ Cu. Ft.

Dry Hole _____

Abandoned _____

Date

FEB 16 1927

S. J. LEWIS Scout