


Section 35 Township 20 Range 6W

Well No. #2 Harder

Company Sterling Drlg.

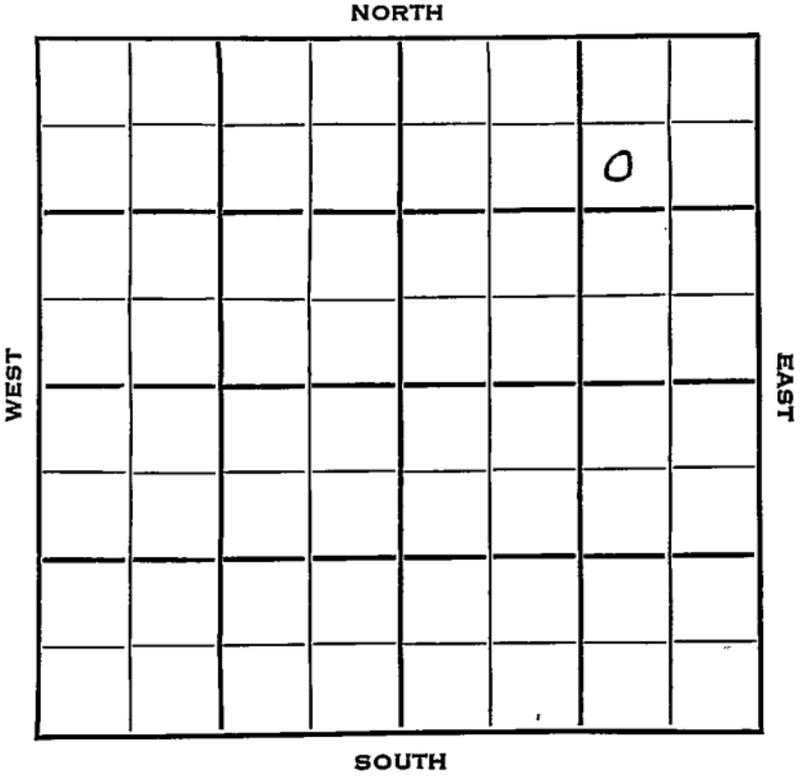

Rice

Sec. 35 Twp. 20 R. 6W

Well No. #2 Harder Farm _____

Sterling Drlg. Company _____

Sterling Drlg. Contractor _____

Welch-Bornholdt Pool


990 Ft. from N. Line

_____ Ft. from S. Line

990 Ft. from E. Line

_____ Ft. from W. Line

SW NE NE

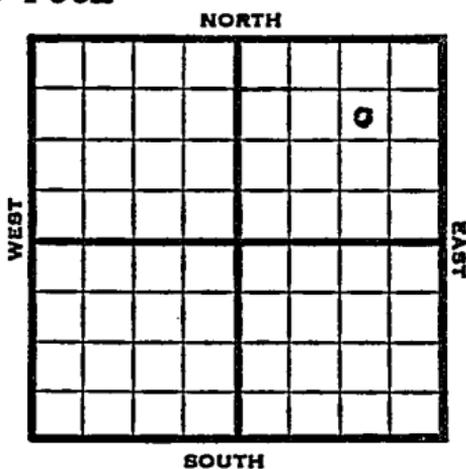

1953

Elev. 1559' REPORT

4/22 Cellar & Pits

4/30 " "

5/7 8" @ 128'
Drlg 2795'

5/21 Lans 2768, Cong 3317, Miss 3350
RTD 3359
5" @ 3359, DD 3390, 1/2 BOPH + 10% W
A-frac

5/28 N.R.

6/3 Spud 4-27-53 Oil well TD 3390
8" @ 128 Lans. 2768' Cong 3317
Miss 3350 TD 3359 5" @ 3359
DD 3390 1/2 BOPH 10% wtr. A-frac.
Comp. 20 BOPD

COMPLETED

