

FORM 51


Rice

KANSAS

Section 35 Township 20 Range 6W

Well No. 1 Walton

Company Sterling Drlg.

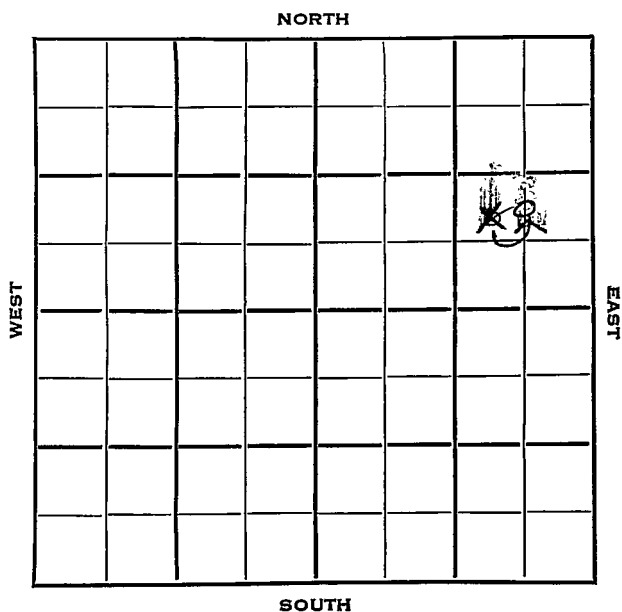

Rice

Sec. 35 Twp. 20 R. 6W

Well No. #1 Walton Farm _____

Sterling Drlg. Company _____

Contractor _____


_____ Ft. from N. Line

990 Ft. from S. Line

~~990~~ 660 Ft. from E. Line

_____ Ft. from W. Line

~~NW SE NE~~
C N L S E N E

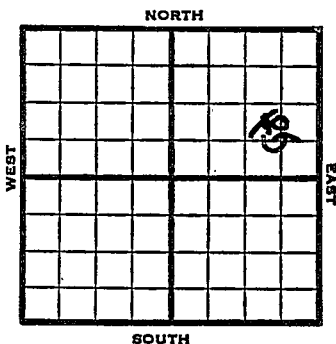

1953

Elev. 1565' REPORT

2/4 Spud 1-31-53
8" @ 130

Drlg. 1650'

2/12 Cong 3330, Miss 3355
RTD 3370
5" @ 3369

2/19 NR

2/26 DD 3379
FU 2800' fluid 12 hrs.

3/11 Spud 1-31-53 Oil well TD 3379
8" @ 130 Cong. 3330 Miss 3355
TD 3370 5" @ 3369 DD 3379
FU 2800' fluid 12 hr.
Comp. 78 BOPD

COMPLETED

Map No. _____ Sec. 35 Twp. 20 R. 6W

Well No. 1 Walton

Sterling Drlg. Company

~~CORRECTION~~ Contractor

C N L S E N E

SECTION PLAT

_____ Ft. from N. Line

990 Ft. from S. Line

660 Ft. from E. Line

_____ Ft. from W. Line

			o

Rice County

Location _____

Rig up _____

Drilling and-Remarks:

Reported
NW SE NE

RECORD

Cased _____ in., _____ ft.

Sand _____

Gas _____

Oil _____

Total Depth _____

PRODUCTION

1st 24 hrs. Nat. _____

1st 24 hrs. after shot _____

Gas _____ Cu. Ft.

Dry Hole _____

Abandoned _____

Date

FEB 4 1953 19

J. G. McGEHEE

Scout

