


Section 35 Township 20 Range 6 W

Well No. #3 Walton "A"

Company Plains Exploration & Sterling Drlg.

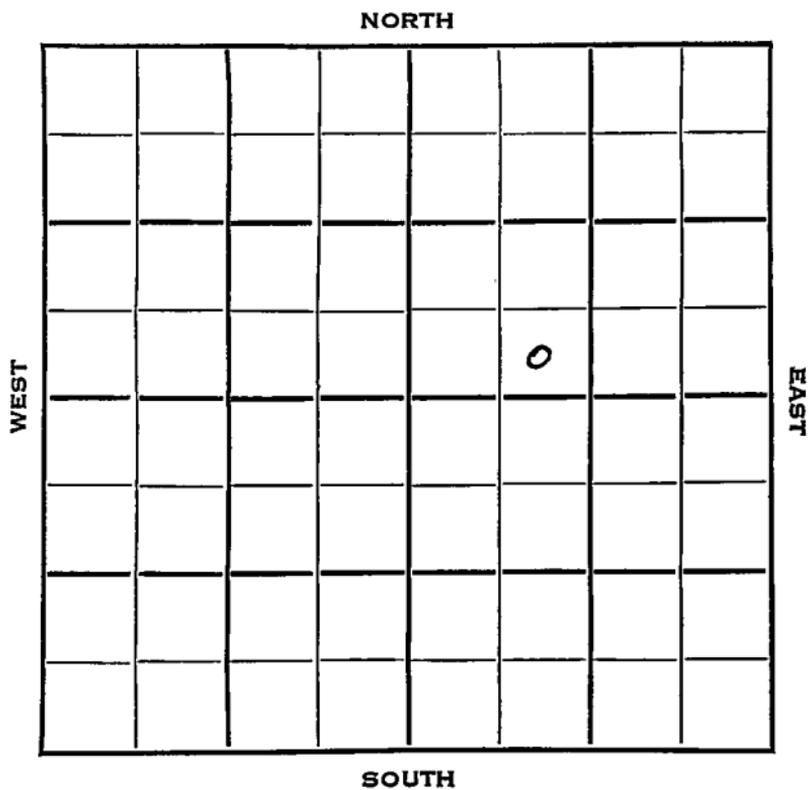

Rice

KANSAS

SEC.	TWP.	R.
35	20	6W

WELL NO.

#3 Walton "A"

FARM

COMPANY

Plains Explor. & Sterling Drlg.

CONTRACTOR

Welch Pool

Ft. from N. Line

330


Ft. from S. Line

Ft. from E. Line

990

Ft. from W. Line

SE SW NE

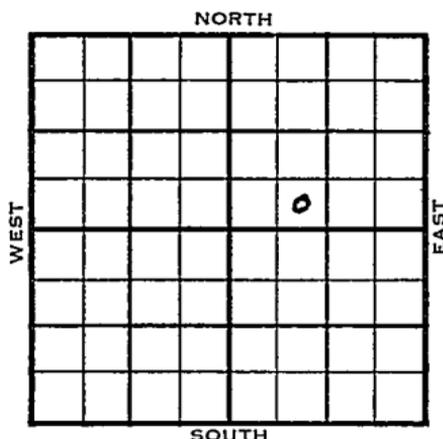

1954

ELEVATION

1581'

REPORT

3/10

Location

3/17

"

3/24

Drlg.

4/7

8" @ 124' w/80 sks
Drlg. 1920'

5/19

Spud 4-1-54

Oil Well

TD 3407'

8" @ 124'

Lans 2795', Cong 3358', Miss 3376'

TD 3391'

5" @ 3390'

DD 3407' FU 2000' oil 10 hr.

sd-frac. S/ 4 boph

Comp 25 bopd.

COMPLETED

