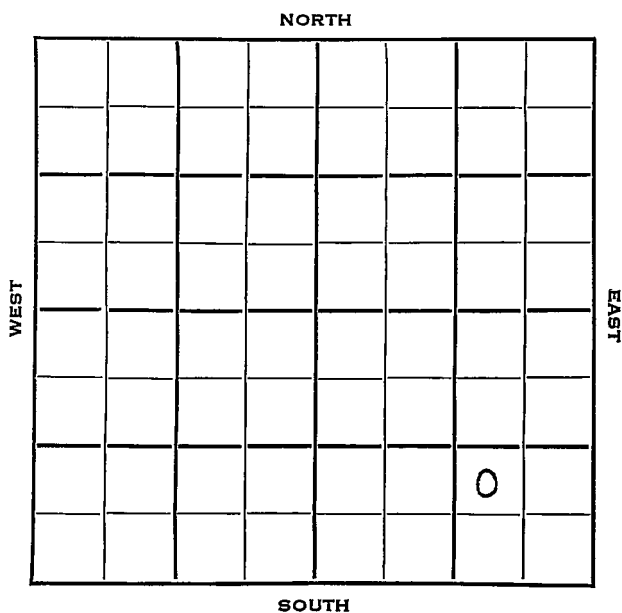


Section 35 Township 20 Range KANSAS 6WWell No. #2 Walton "B"Company Plains Exploration & Sterling Drlg.

Rice

KANSAS

SEC.	TWP.	R.
35	20	6W

WELL NO.

#2 Walton "B"

FARM

COMPANY

Plains Exploration & Sterling Drlg.

CONTRACTOR

Sterling Drlg.

Welch-Bornholt Pool NORTH


Ft. from N. Line

990 Ft. from S. Line

990 Ft. from E. Line

Ft. from W. Line

NW SE SE

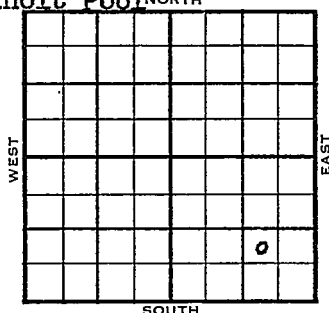


	ELEVATION	REPORT
1953	1584'	

10/7	Location
10/14	"
10/21	MI
10/28	8" @ 128'
	Drlg. 2300'
11/4	Lans 2808', Cong 3376', Miss 3410'
	RTD 3414'
	5" @ 3412'
11/11	NR
11/18	NR
12/9	Spud 10-19-53
	Oil Well
	TD 3428'
	8" @ 128'
	Lans 2808', Cong 3376', Miss 3410'
	TD 3414'
	5" @ 3412'
	DD 3428 $\frac{1}{4}$ BOPH 30% wtr.
	Sd-frac,
	S/4 bo 1 bwph 8 hrs.
	Comp. 30 bopd 10 bw

COMPLETED

County Rice State Kansas
 Sec. 35 (Blk.) 20 (Sur. Rge.) 6W Map No. _____
 Operator Plains Exploration & Sterling Drlg.
 Well No. 2 Farm Walton "B" #1
 Elev. 1584 Location NW SE SE

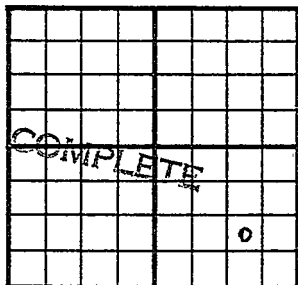

990 Ft. From S Line SE
990 Ft. From E Line Quarter

1st. Report

Completion DEC 9 1953

Remarks Welch-Bornholt Pool
Sterling Drlg. - Contr.

Spudding Date 10-19-53

Drlg. Data Oil well TD 3428

8" @ 128 Lams. 2808 Cong. 3376

Miss. 3410 TD 3414 5" @ 3412

DD 3428 $\frac{1}{4}$ boph 30% wtr. sd-frac

S/ 4 bo 1 bwph 8 hr.

Comp. 30 bopd 10 bw

J. G. MCGEE