

Rice

Map No. Kansas Sec. 35 Twp. 20 R. 6^W

Well No. 1 Welch Farm


Welch O & G. Company

_____ Ft. from N. Line

200 Ft. from S. Line

_____ Ft. from E. Line

200 Ft. from W. Line

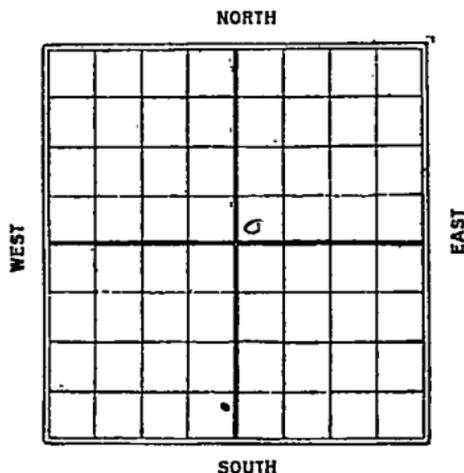

Date	REPORT
1926	
3/17	moving in log
4/14	drilling 2950 700
4/25	" 1625
4/29	Dlg 1800
5/5	" 3360 2700'
5/12	" 2750'
5/26	" 3025'
6/2	" 3170'
6/9	" 3250
6/16	" - 3270
6/23	T & S 3382-3417-165 ft oil
	and water T.D. 35-50
6/30	S.D.
7/14	same
7/21	—
8/11	—
8/18	—
8/25	—
8/31	—
9-8	Dry 2 abd. 2.0. 3550'

no map
KANSAS

Map No. _____ Sec. 35 Twp. 20 R. 6 N

Well No. 1 *Heck*

Wiley O & G Company

Contractor _____

SECTION PLAT

		0	

_____ Ft. from N. Line

200 Ft. from S. Line

_____ Ft. from E. Line

200 Ft. from W. Line

FIRST REPORTS

Location _____

Rig up _____

Drilling and Remarks:

Stopping in rig

RECORD

Cased _____ in., _____ ft.

Sand _____

Gas _____

Oil _____

Total Depth _____

PRODUCTION

1st 24 hrs. Nat. _____

1st 24 hrs. after shot _____

Gas _____ Cu. Ft.

Dry Hole _____

Abandoned _____

Date

MAR 17 1926

S. J. LEWIS

Scout


Rice

MAP NO. KANSAS SEC. 35 TWP. 20S R. 6W
 WELL NO. 1 *W. Leche*

W. Leche COMPANY

CONTRACTOR

SECTION PLAT

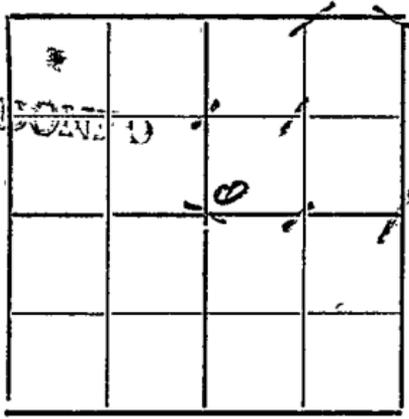

_____ FT. FROM N. LINE
 _____ FT. FROM S. LINE
 _____ FT. FROM E. LINE
 _____ FT. FROM W. LINE

O.K.

LOCATION _____

RIG UP _____

DRILLING AND REMARKS:

*check no unit
 see maps*

RECORD

CASED _____ IN., _____ FT.
 SAND _____
 GAS _____
 OIL _____
 TOTAL DEPTH 3550

PRODUCTION

1ST 24 HRS. NAT. _____
 1ST 24 HRS. AFTER SHOT _____
 GAS _____ CU. FT.
 DRY HOLE
 ABANDONED

DATE

7/17 1926

SCOUT

Map No. KANSAS Sec. 35 Twp. 20 R. 6 W

Well No. 1

Wilcox Dr. Co. Company

Contractor

SECTION PLAT

		0	

_____ Ft. from N. Line

200 Ft. from S. Line

_____ Ft. from E. Line

200 Ft. from W. Line

ABANDONED

RECORD

Location _____

Cased _____ in., _____ ft.

Rig up _____

Sand _____

Drilling and Remarks:

Gas _____

T II 3550

Oil _____

II & A.

Total Depth _____

PRODUCTION

1st 24 hrs. Nat. _____

1st 24 hrs. after shot _____

Gas _____ Cu. Ft.

Dry Hole _____

Abandoned _____

Date

SEP 8 1926

S. J. LEWIS

Scout