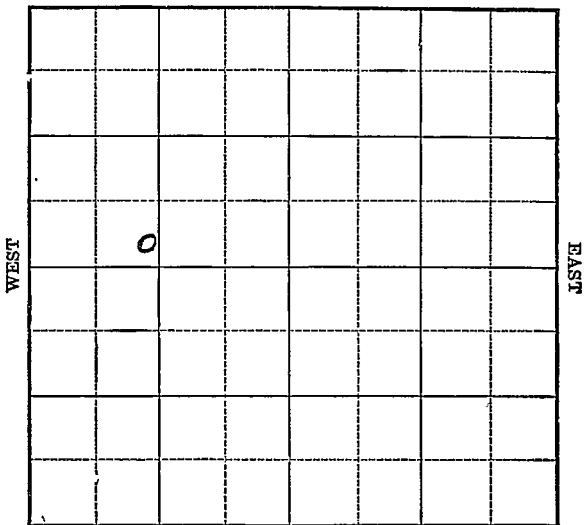


Map No. Tree Sec. 35 Twp. 20^S R. 6^W

Well No. 1. Welch Farm

Hipple & 1 bluds Company

NORTH



SOUTH

Location _____

Drilling Remarks:

RECORD

Cased _____ in. _____ ft.
 Sand _____
 Gas _____
 Oil _____
 Total Depth _____

Rig Up _____

Drilling Remarks:

PRODUCTION

1st 24 hrs. Nat. _____
 1st 24 hrs. after shot _____
 Gas _____ cu. ft.
 Dry Hole _____
 Abandoned _____

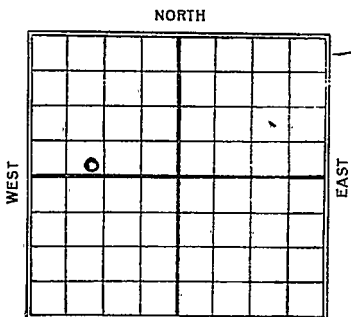
Map No. 7C Sec. 35 Twp. 20th R. 6thWell No. 1. Welch FarmHipple Ed Childs Company

Ft. from N. Line

Ft. from S. Line

Ft. from E. Line

Ft. from W. Line

This information taken from ^{SOUTH} telephone report.

REPORT

Date

3/7

1st pay - 3391 - 95

Lime shell. 3395 - 96

2nd pay - 3396 - 3404 1/2

Lime shell - 3404 1/2 - 3405 1/2

Swab 70 lbs 6 hrs.

4/9

Lime and Chat

3384 - 3400'

Est at 50 Bbls

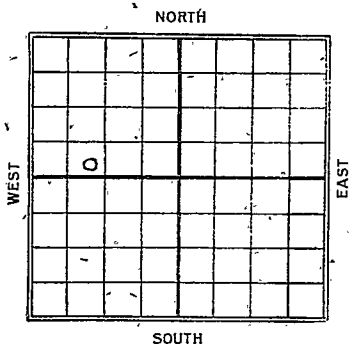
Ree, Co.

Map No. Kan Sec. 35 Twp. 20 R. 6^WWell No. 1 Welch FarmHyspie & Childs Company

_____ Ft. from N. Line

200 Ft. from S. Line

_____ Ft. from E. Line

1120 Ft. from W. Line1st Report & Completion

Date

REPORT

192411/233384-3400 70 Bbls

Map No. W. 1/4 Sec. 35 Twp. 20 R. 6W

Well No. #1 Welch

Shipple & Childs Company

Contractor

FIRST REPORT

COMPLETED

Ft. from N. Line

200 Ft. from S. Line

Ft. from E. Line

1120 Ft. from W. Line

SECTION PLAT

0			

Location

Rig up

Drilling and Remarks:

Lime & Chat

3384-3400'

setting oiler & gas

est bet 50 bbls

RECORD

Cased _____ in., _____ ft.

Sand _____

Gas _____

Oil _____

Total Depth _____

PRODUCTION

1st 24 hrs. Nat. _____

1st 24 hrs. after shot _____

Gas _____ Cu. Ft.

Dry Hole _____

Abandoned _____

Date

APR 9 1924

M. A. BENEAR

192

Scout

Rice Co.
 Map No. **KANSAS** Sec. **35** Twp. **20** R. **6W**
 Well No. **1 Welch**
Whipple & Childs Company

Contractor

COMPLETED**SECTION PLAT**

_____Ft. from N. Line

200 Ft. from S. Line

_____Ft. from E. Line

1120 Ft. from W. Line

0			

1st & Completion

Location _____

Rig up _____

Drilling and Remarks:

Pay Chat
3384-3400'
70 lbs

RECORD

Cased _____ in., _____ ft.

Sand _____

Gas _____

Oil _____

Total Depth _____

PRODUCTION

1st 24 hrs. Nat. _____

1st 24 hrs. after shot _____

Gas _____ Cu. Ft.

Dry Hole _____

Abandoned _____

Date

NOV 23 1924**M. A. BENEAR****192**

Scout

MAP No. KANSAS 35. 2056A SEC. 35 TWP. 20S6N

WELL No. Pririe

COMPANY

CONTRACTOR

SECTION PLAT

Ft. FROM N. LINE

Ft. FROM S. LINE

Ft. FROM E. LINE

Ft. FROM W. LINE

OK

LOCATION

RIG UP

DRILLING AND REMARKS:

Chato or dry lim
3370-3416
P.L.M.
100 bbls.
deposited to
3490

RECORD

CASED IN. FT.

SAND

GAS

OIL

TOTAL DEPTH 3490

PRODUCTION

1ST 24 HRS. NAT.

1ST 24 HRS. AFTER SHOT

GAS CU. FT.

DRY HOLE

ABANDONED

DATE

New pumping 120 lbs.

7/18 1926

SCOUT