


Map No. 11 Sec. 35 Twp. 20 R. 6^w

Well No. 3 Welch "B" Farm _____

Prairie O. & G. Company

NORTH

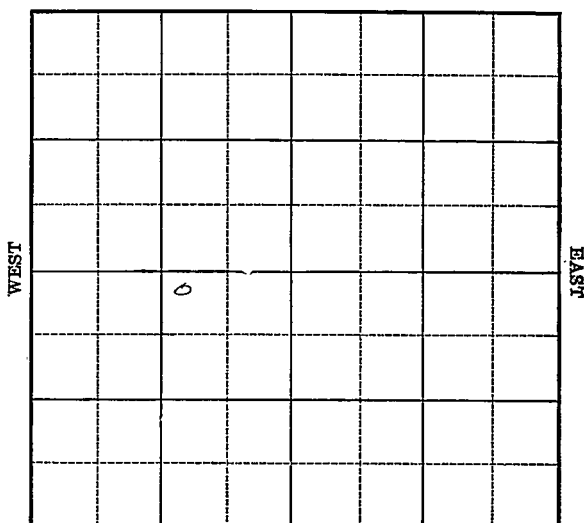

SOUTH

ONDD

Location _____

Drilling Remarks

Rig Up_____

Drilling Remarks

RECORD

Cased_____in. _____ft.

Sand

Gas _____

Oil

Total Depth _____

PRODUCTION

1st 24 hrs. Nat. _____

1st 24 hrs. after shot -----

Gas _____ cu. ft.

Dry Hole_____

Abandoned _____

Rice Co.

Map No. ~~KANSAS~~ Sec. 35 Twp. 20 R. 6W.

Well No. #3 Welsh "B" Farm


Prarie O. G. Company

300 Ft. from N. Line

Ft. from S. Line

990 Ft. from E. Line

Ft. from W. Line

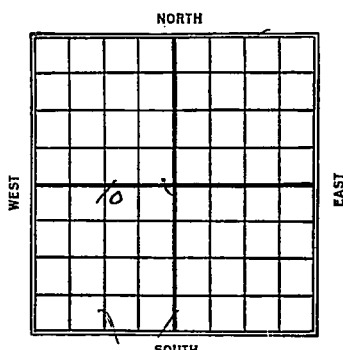

1926.

Date

REPORT

5/19	Location
5/26	
6/2	R.O.G.
6/9	R.O.G.
6/16	Rig.
6/23	Rigging up
6/30	Dlg- 850
7/14	" 2020
7/21	T.D. 2030 U.P.
8/11	
8/18	T.D. 2125 - Collapsed pipe
8/25	Lost hole - T.D. 2125, skid rig 50 ft north.
9/1	rigging up
9/8	Dlg 280
9/15	" 513
9/22	" 1755
9/29	" 2150
10/6	" 2360
10/13	" 2615
10/20	" 2820
	T.D. 2940 - U.P.

11/3 - Drily 3100'
11/10 - I.D. 3175 W.P.
11/17 - Drily 3320

11/24 - Top chat 3401 Drily 3480-1800 ft. Oiling ^{hole}
12/1 - Top chat 3401 - I.D. 3508
15 bbls

1929 OWDD

6/5 - Regu up

6/5

6/12

6/19

6/26 - Sewed ge 5" - T.D. 3508

7/2 - Verlg 3550'

7/10 - " 3625'

7/17 - V/R 5" - 3625'

7/24

7/31 - Verlg 3680'

8/7 - show oil 3700-03

5" - 3703' HFW 3752'

S.I.D. 3763'

8/14 - HFW at 3768

T.D. 3804

Dry & Abandoned

Map No. KANSAS Sec. 35 Twp. 20 R. 6WWell No. 3 HelahPrairie O & G Company

Contractor


SECTION PLAT

300 Ft. from N. Line

Ft. from S. Line

990 Ft. from E. Line

Ft. from W. Line

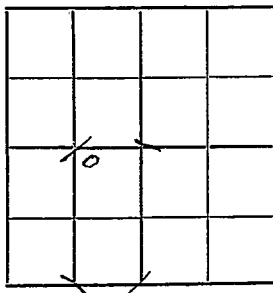

FIRST REPORTS

Location

Rig up

Drilling and Remarks:

Location

RECORD

Cased _____ in., _____ ft.

Sand _____

Gas _____

Oil _____

Total Depth _____

PRODUCTION

1st 24 hrs. Nat. _____

1st 24 hrs. after shot _____

Gas _____ Cu. Ft.

Dry Hole _____

Abandoned _____

Date

MAY 19 1926S. J. LEWIS

Scout

MAP No. KANSAS SEC. 35 TWP. 70S R. 6N
 WELL No. 3 Welch

Prairie COMPANY

churns with CONTRACTOR
cutting

SECTION PLAT

	0		

ABANDONED

_____ FT. FROM N. LINE

_____ FT. FROM S. LINE

_____ FT. FROM E. LINE

_____ FT. FROM W. LINE

O.K.

LOCATION _____

RIG UP _____

DRILLING AND REMARKS:

2185 lost hole
skidded rig
40' south

RECORD

CASED _____ IN. _____ FT.

SAND _____

GAS _____

OIL _____

TOTAL DEPTH 2125

PRODUCTION

1ST 24 HRS. NAT. _____

1ST 24 HRS. AFTER SHOT _____

GAS _____ CU. FT.

DRY HOLE ☒

ABANDONED ☒

DATE

8/23 1926

SCOUT

Rice
KANSAS
 MAP NO. *100* SEC. *35* TWP. *20S* R. *6W*
 WELL NO. *3A Welch*
Price _____ COMPANY _____

check with
one up _____ CONTRACTOR _____

SECTION PLAT

	0		

_____ FT. FROM N. LINE *ABANDONED*
 _____ FT. FROM S. LINE
 _____ FT. FROM E. LINE
 _____ FT. FROM W. LINE

OK

LOCATION _____

RIG UP _____

DRILLING AND REMARKS:

3401-3508
would chat
15 ft
3rd

RECORD

CASED _____ IN. _____ FT.
 SAND _____
 GAS _____
 OIL _____
 TOTAL DEPTH *3508*

PRODUCTION

1ST 24 HRS. NAT. _____
 1ST 24 HRS. AFTER SHOT _____
 GAS _____ Cu. Ft.
 DRY HOLE _____
 ABANDONED _____

DATE

12/1 *4*

SCOUT

File map
 Map No. **KANSAS** Sec. 35 Twp. 20 R. 6 W

Well No. 3 WelchPrairie Oil & Gas Company

Contractor


SECTION PLAT

200 Ft. from N. Line

_____ Ft. from S. Line

990 Ft. from E. Line

_____ Ft. from W. Line

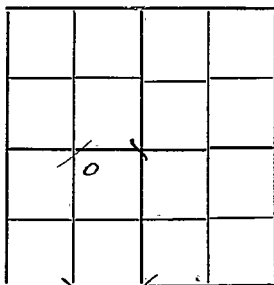COMPLETED

Location _____

Rig up _____

Drilling and Remarks:

Top Chas 3401TJ 350815 8 8 1/2.

RECORD

Cased _____ in., _____ ft.

Sand _____

Gas _____

Oil _____

Total Depth _____

PRODUCTION

1st 24 hrs. Nat. _____

1st 24 hrs. after shot _____

Gas _____ Cu. Ft.

Dry Hole _____

Abandoned _____

Date

DEC 1 - 1926

S. J. LEWIS

_____ 192

Scout

48

Map No. KANSAS Sec. 35 Twp. 20 R. 6WWell No. 3 1/2 1/4 "B"Prairie Oil & Gas Company

Contractor

SECTION PLAT

330 Ft. from N. Line

Ft. from S. Line

990 Ft. from E. Line

Ft. from W. Line

	0		

OW 111

Location

Rig up

Drilling and Remarks:

RECORD

Cased _____ in., _____ ft.

Sand _____

Gas _____

Oil _____

Total Depth _____

PRODUCTION

1st 24 hrs. Nat. _____

1st 24 hrs. after shot _____

Gas _____ Cu. Ft.

Dry Hole _____

Abandoned _____

Date

JUN 5 1929

192

S. J. LEWIS

Scout

Map No. **KANSAS** Sec. **35** Twp. **20** R. **6 W**

Well No. **3 1/2 1/4 "B"**

Prairie O & G Company

Contractor

SECTION PLAT

330 Ft. from N. Line

Ft. from S. Line

990 Ft. from E. Line

Ft. from W. Line

	0		

ABANDONED

Location

Rig up

Drilling and Remarks:

HW 3768

RECORD

Cased in, ft.

Sand

Gas

Oil

Total Depth **3804**

PRODUCTION

1st 24 hrs. Nat.

1st 24 hrs. after shot

Gas Cu. Ft.

Dry Hole

Abandoned

Date
AUG 14 1929

192

S. J. LEWIS Scout