

KANSAS

Rice


Form 51-5M-7-39-Palace

Section 36 Township 20 Range 6-W

Well No. #2 Carlson

Company Continental et al

NORTH **Bornholdt Pool**

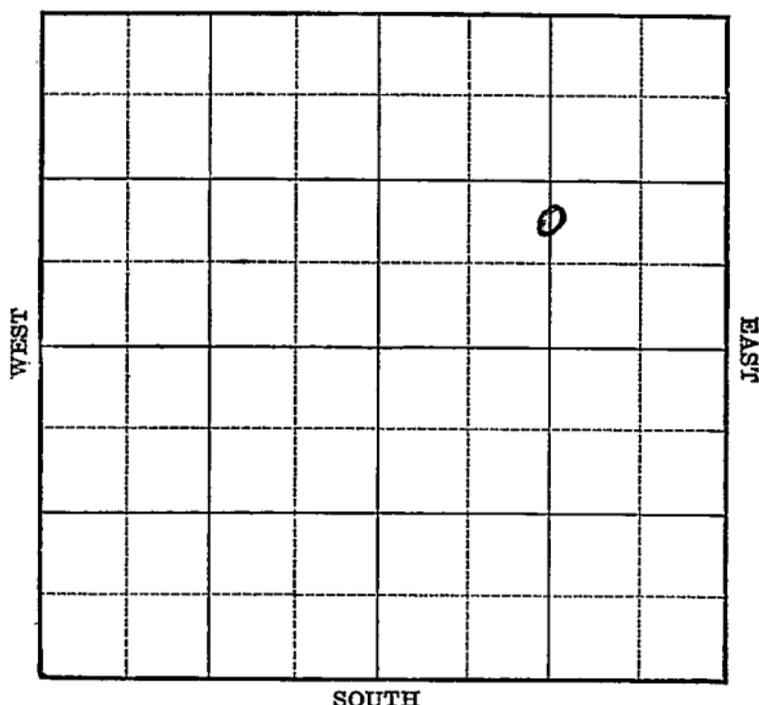

Map No. 48 Sec. 36 Twp. 20 R. 6WWell No. 2 Carlson

Continental etal . Company

Contractor

FIRST REPORT

C N L S $\frac{1}{2}$ NE

Ft. from N. Line

990 Ft. from S. Line1320 Ft. from E. Line

Ft. from W. Line

SECTION PLAT

BORNHOLDT POOL

Location _____

Rig up _____

Drilling and Remarks:

Running Derrick

Corners

RECORD

Cased _____ in., _____ ft.

Sand _____

Gas _____

Oil _____

Total Depth _____

PRODUCTION

1st 24 hrs. Nat. _____

1st 24 hrs. after shot _____

Gas _____ Cu. Ft.

Dry Hole _____

Abandoned _____

Date

MAY 1 1940

19

S. J. LEWIS Scout

Map No. 48 Sec. 36 Twp. 20 R. 6WWell No. 2 CarlsonContinental etal Company

Contractor

COMPLETED

SECTION PLAT

C N L S $\frac{1}{2}$ NE Ft. from N. Line990 Ft. from S. Line1320 Ft. from E. Line Ft. from W. Line

BORNHOLDT POOL

Location Rig up

Drilling and Remarks:

@ 32866" @ 3286Flow 346 P.D.

RECORD

Cased in., ft.Sand Gas Oil Total Depth 3350

PRODUCTION

1st 24 hrs. Nat. 1st 24 hrs. after shot Gas Cu. Ft.Dry Hole Abandoned

Date

JUN 12 1940 19 S. J. LEWIS Scout